


~~A 35183~~
35183
C-43644

T.13S., R.28E., W.M.

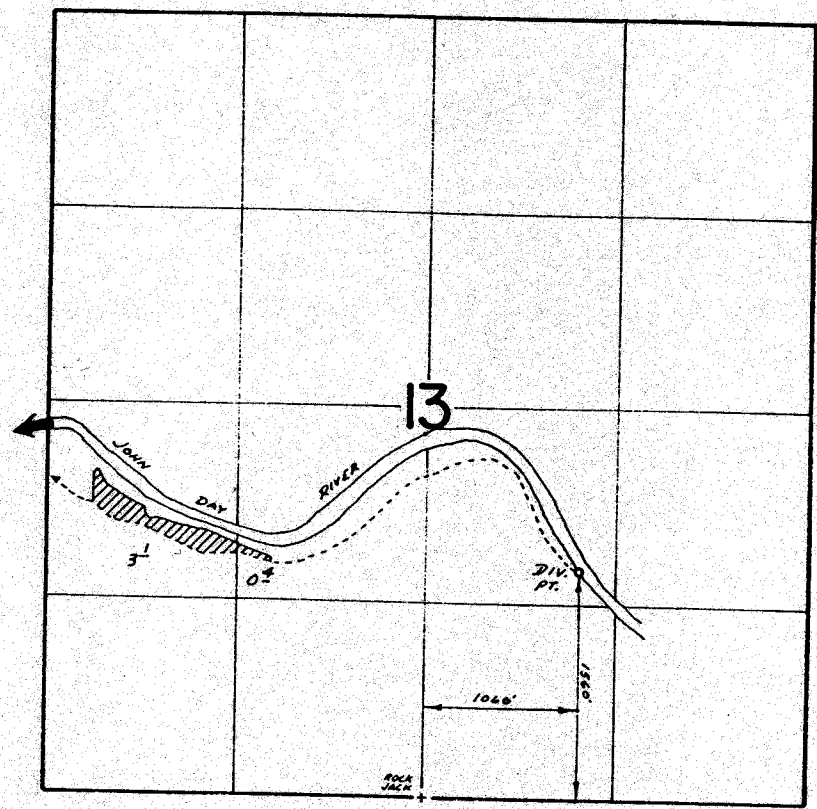

FINAL PROOF SURVEY
UNDER

Application No. 47038 Permit No. 35183
IN NAME OF

R. R. (TODD) MOORE

Surveyed June 21 1975, by D. Norby