


# T. 38 S. R. 1 W. W.M.

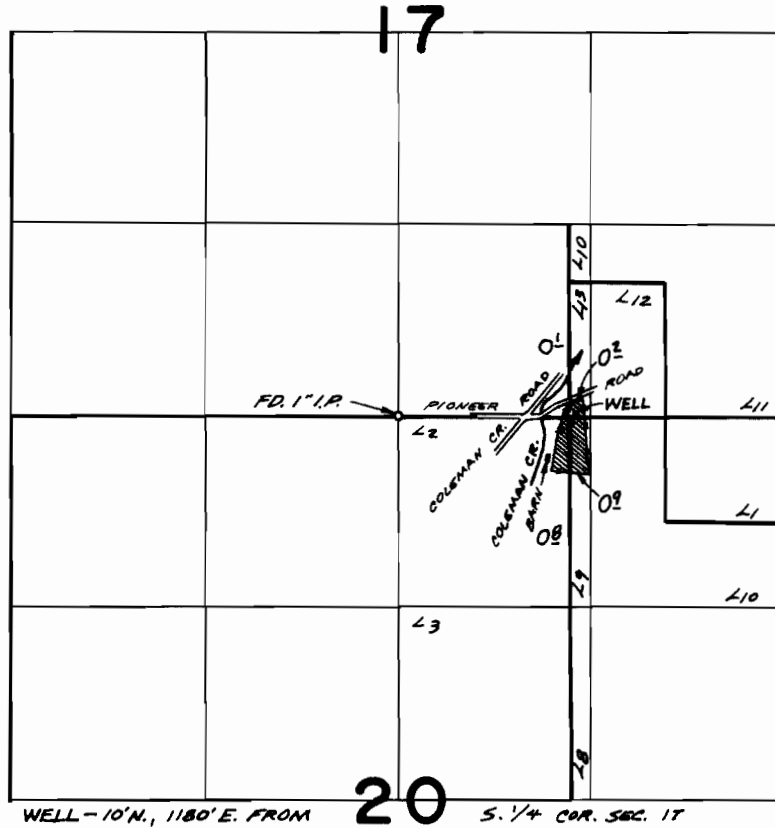

## FINAL PROOF SURVEY UNDER

Application No. G.4875 Permit No. G.4590  
IN NAME OF

ANTHONY AND SANDRA VERBURGT

Surveyed 4/4/75 1974, by L.M. TOLLE