


T.35S.,R.3W.,W.M.

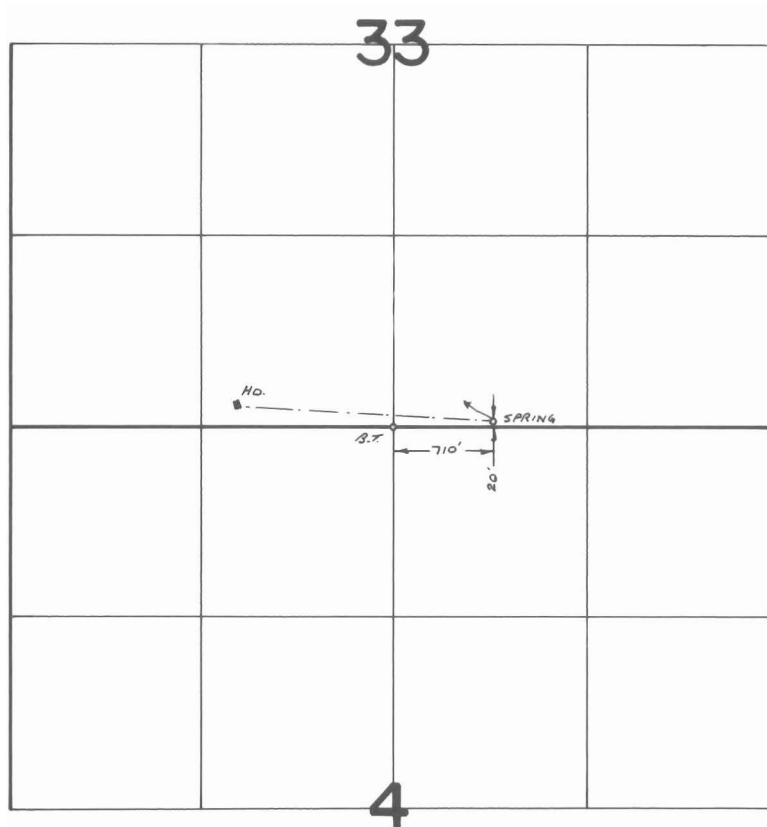

**FINAL PROOF SURVEY**  
UNDER

Application No. 49602 Permit No. 37169  
IN NAME OF

WARREN B. WILSON

Surveyed Aug. 13 1975, by L. E. Gould