


T.11S.,R.13E.,W.M.

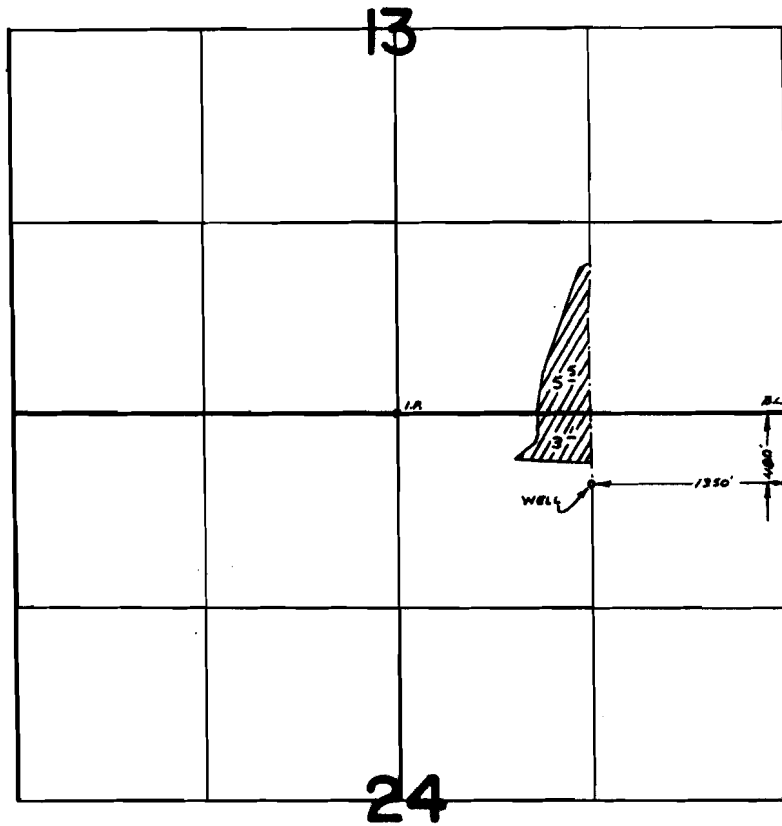

FINAL PROOF SURVEY UNDER

Application No. G-4725 Permit No. G-4446
IN NAME OF

ERROL & MARGRET SCHNIDER

Surveyed June 12 1975, by L. E. Goulo

G-4446
JUN 12 1975