


T.12S.,R.15E.,W.M.

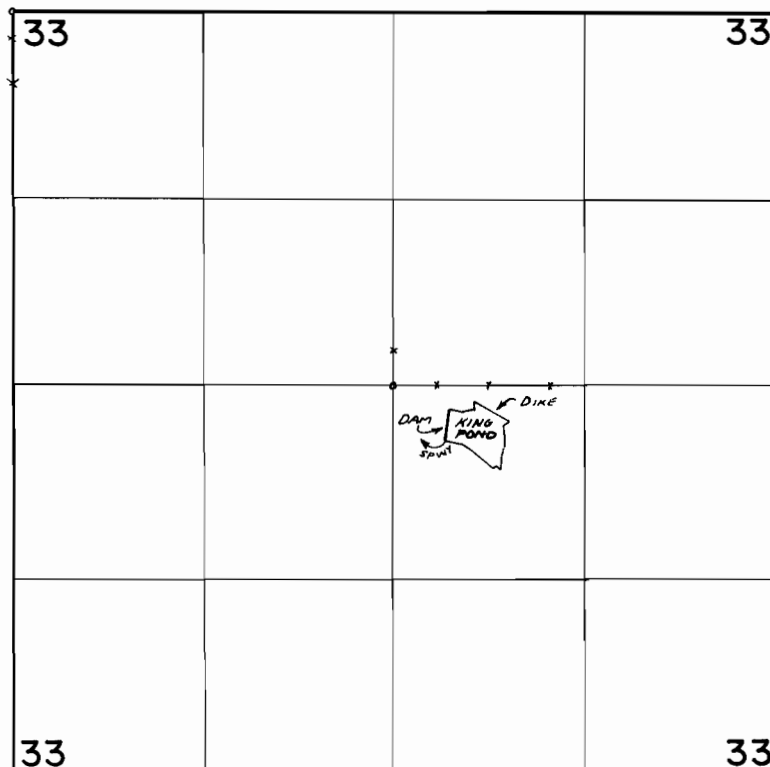

FINAL PROOF SURVEY
UNDER

Application No. R-44669 Permit No. R-5635
IN NAME OF

MORROW BROS., INC.

Surveyed JUNE 14 1975, by L. E. GOULD