


T.9S.,R.13E.,W.M.

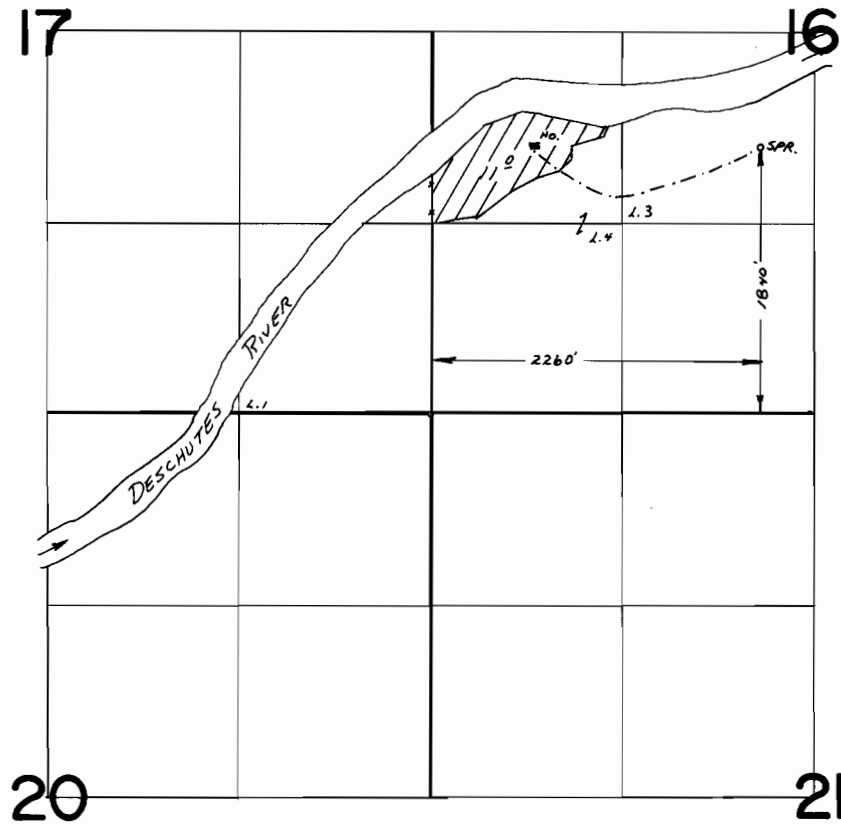

FINAL PROOF SURVEY
UNDER

Application No. 49241 Permit No. 36904
IN NAME OF

CHESTER S. & AMY B. LUELLING

Surveyed JUNE 10 1975, by L.E. Gault