


T. 35 S. R. 58 & 6 W. W.M.

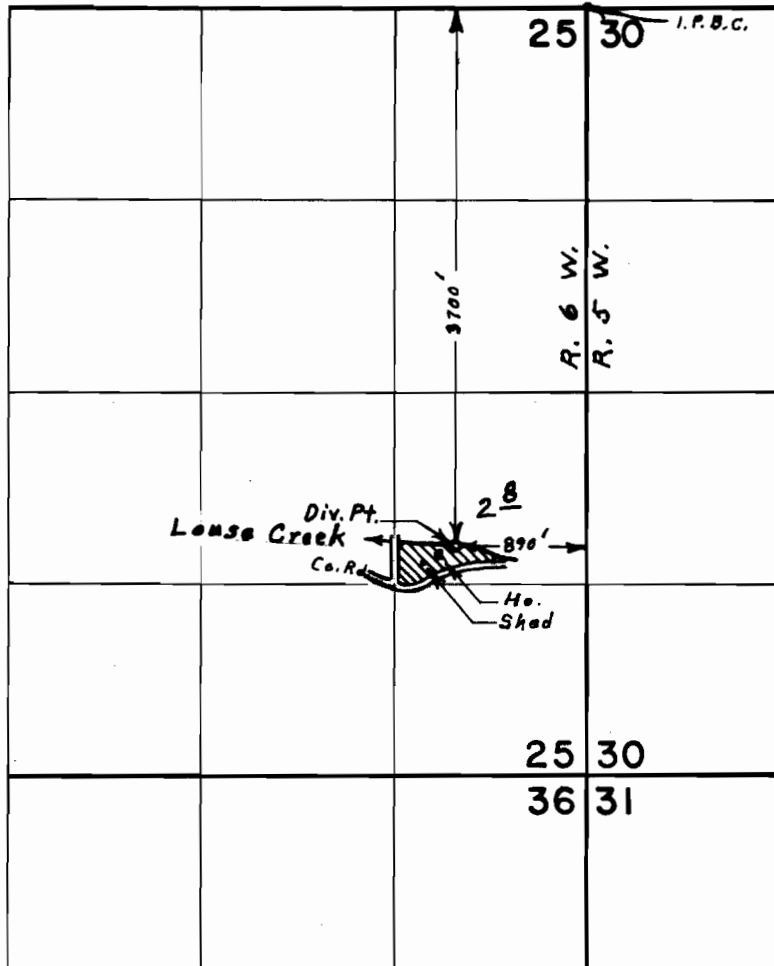

FINAL PROOF SURVEY
UNDER

Application No. 48371 Permit No. 36316
IN NAME OF

RICHARD & HARLEY SUE DIETZ

Surveyed April 2, 1975, by L. E. Gould