


T.17S. R.8W. W.M.

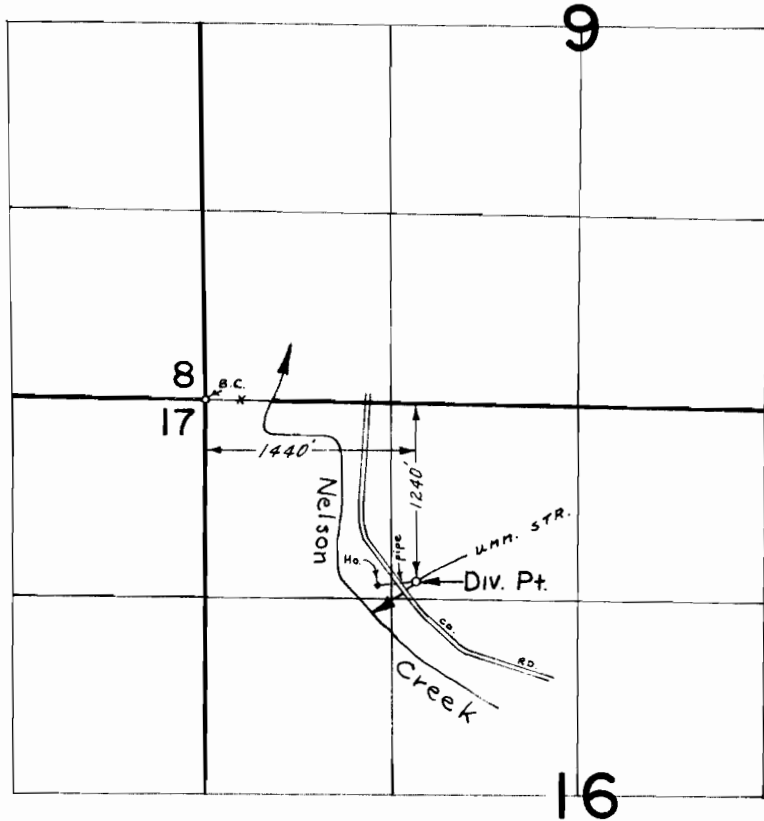

**FINAL PROOF SURVEY**  
UNDER

Application No. 42986 Permit No. 32117  
IN NAME OF

GEORGE L. CURRY

Surveyed May 9, 1975, by R. Mucken