


T.16S. R.7W. W.M.

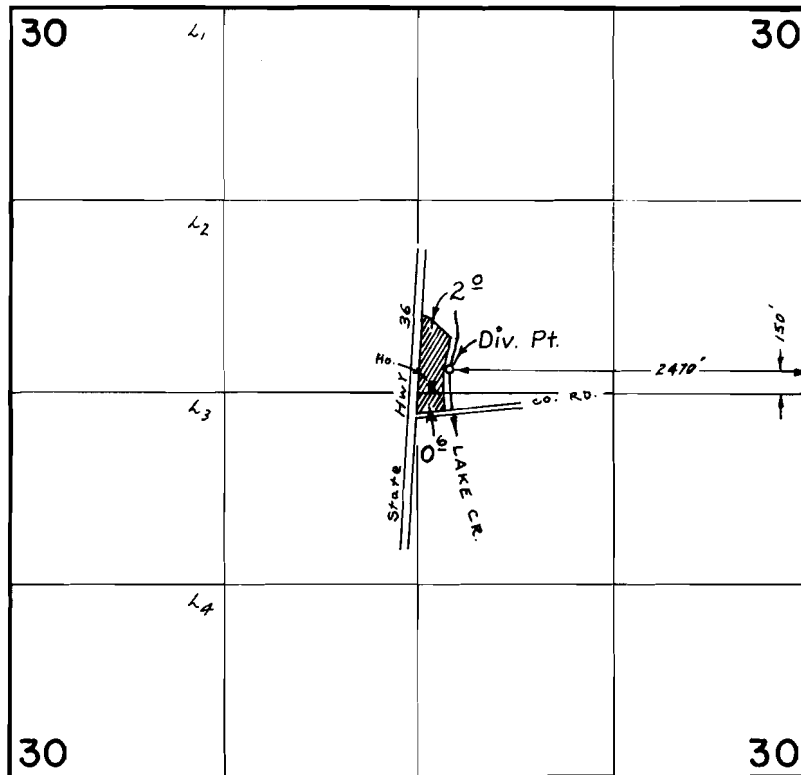

**FINAL PROOF SURVEY**  
UNDER

Application No. 45016 Permit No. 33647  
IN NAME OF

Mr. & Mrs. C. A. MITCHELL

Surveyed MAY 8, 1975, by R. MUCKEN