


T.16S. R.2E. W. M.

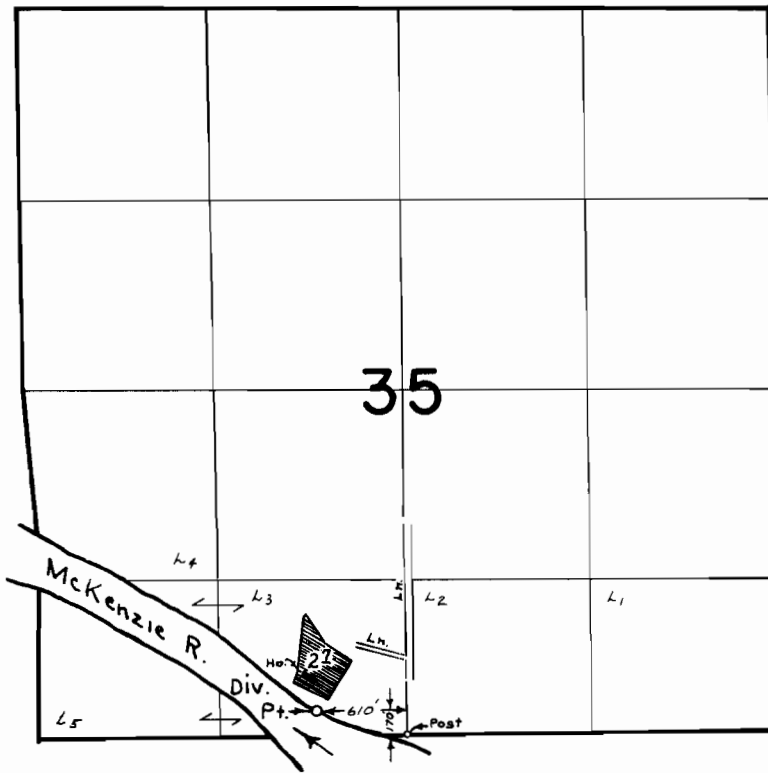

**FINAL PROOF SURVEY**  
UNDER

Application No. 47605 Permit No. 35634  
IN NAME OF

CLARE K. HAMLIN

Surveyed APRIL 24, 1975, by R. MUCKEN