


T.19S. R.12W. W.M.

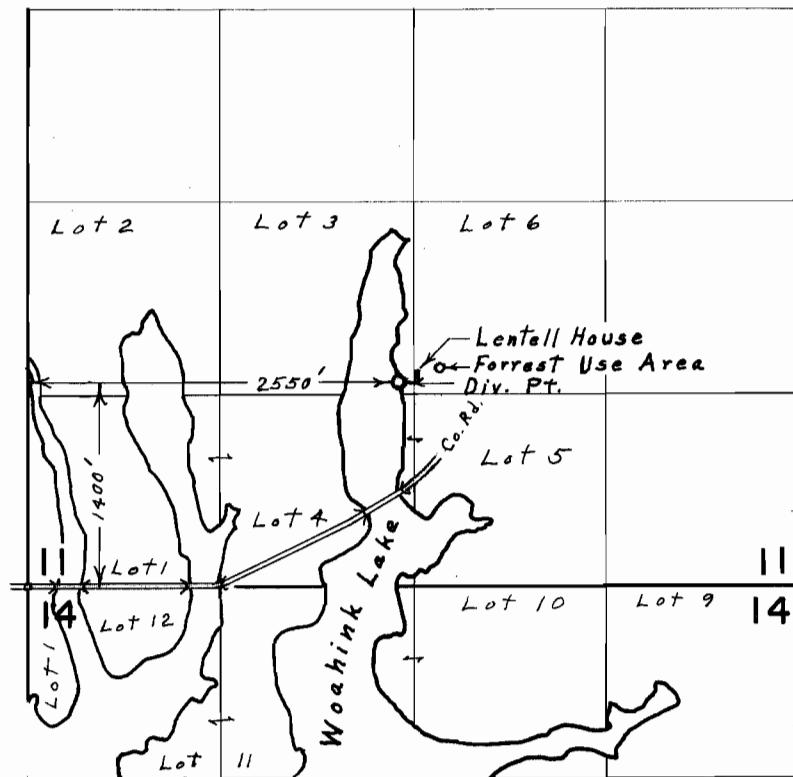

FINAL PROOF SURVEY
UNDER

Application No. 47903 Permit No. 35895
IN NAME OF

BEN LENTELL & EMORY FORREST

Surveyed July 8, 1974, by L. E. Gould