


T.16S. R.6W. W. M.

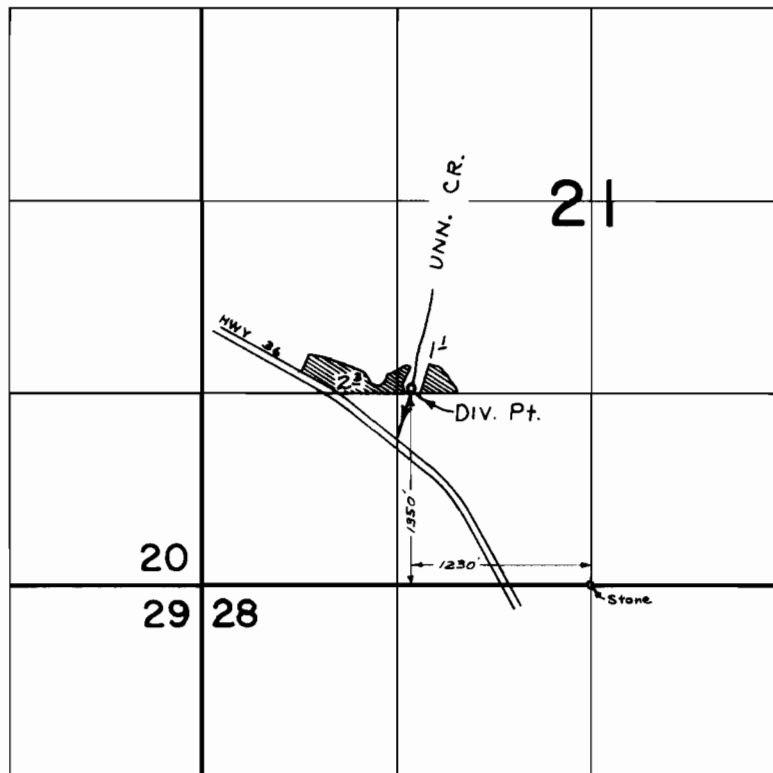

FINAL PROOF SURVEY
UNDER

Application No. 48008 Permit No. 36006
IN NAME OF

HAROLD H. SCHAEFER

Surveyed MAY 1, 1975, by R. MUCKEN