


T.16S. R.7W. W. M.

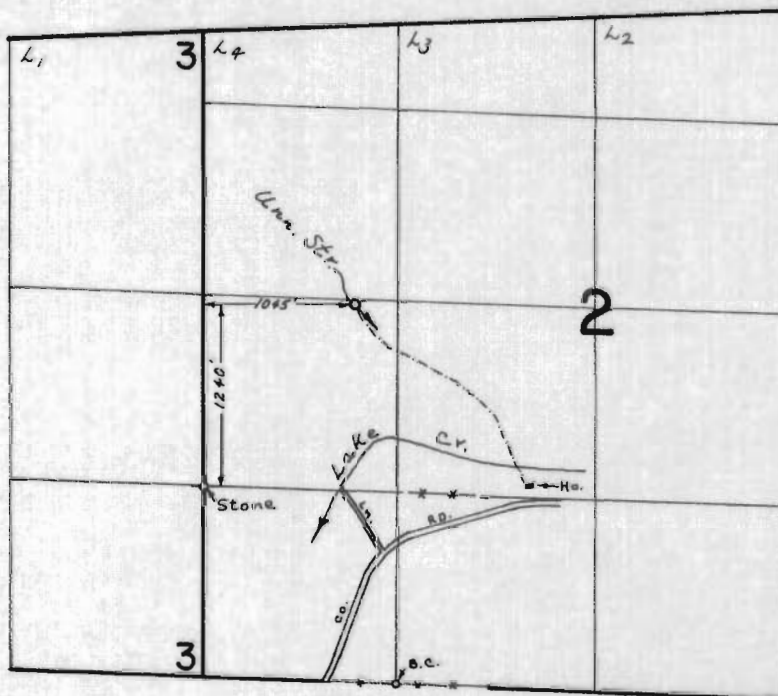

FINAL PROOF SURVEY
UNDER

Application No. 49888 Permit No. 37513
IN NAME OF _____

BRUCE R. PATTERSON

Surveyed May 6, 1975, by R. Mucken