


T.16S. R.7W. W. M.

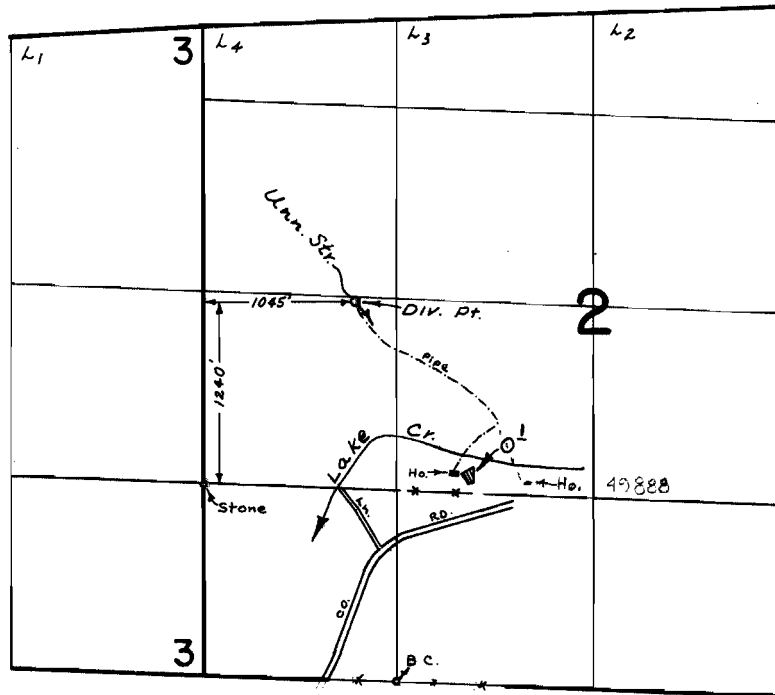

FINAL PROOF SURVEY
UNDER

Application No. 49889 Permit No. 37517
IN NAME OF

AGRICULTURAL DEVELOPMENT ASSN., INC.

Surveyed May 6, 1975, by R. Mucken