


T.I.S., R.I.W., W.M.

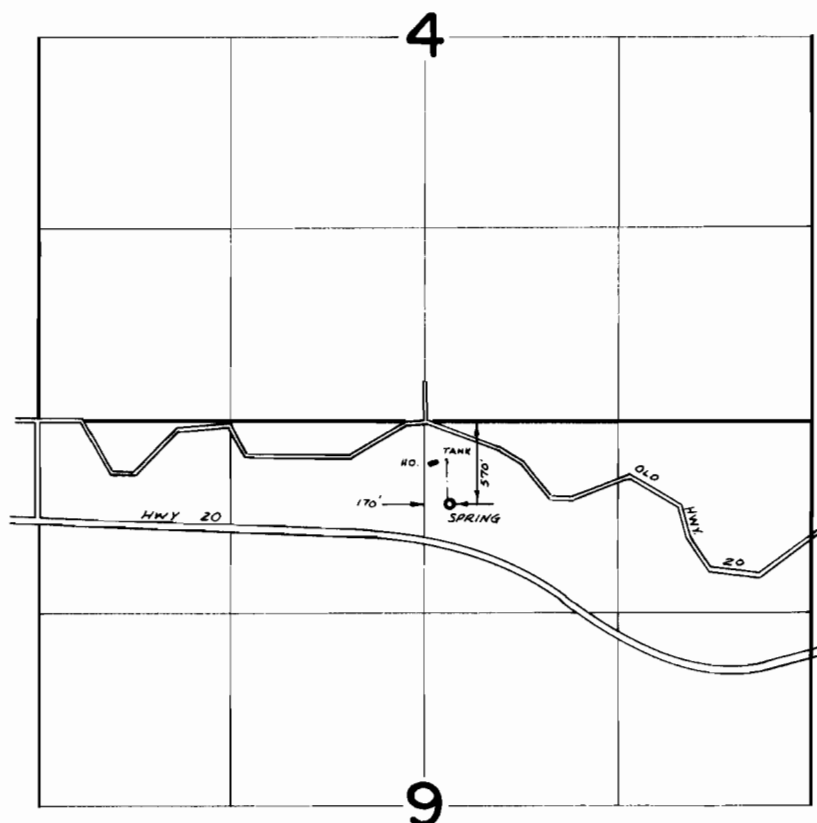

FINAL PROOF SURVEY
UNDER

Application No. 48001 Permit No. 36000
IN NAME OF

GEORGE FOGARTY

Surveyed June 6 1975, by D. Norby