


# T.11S., R.4W., W.M.

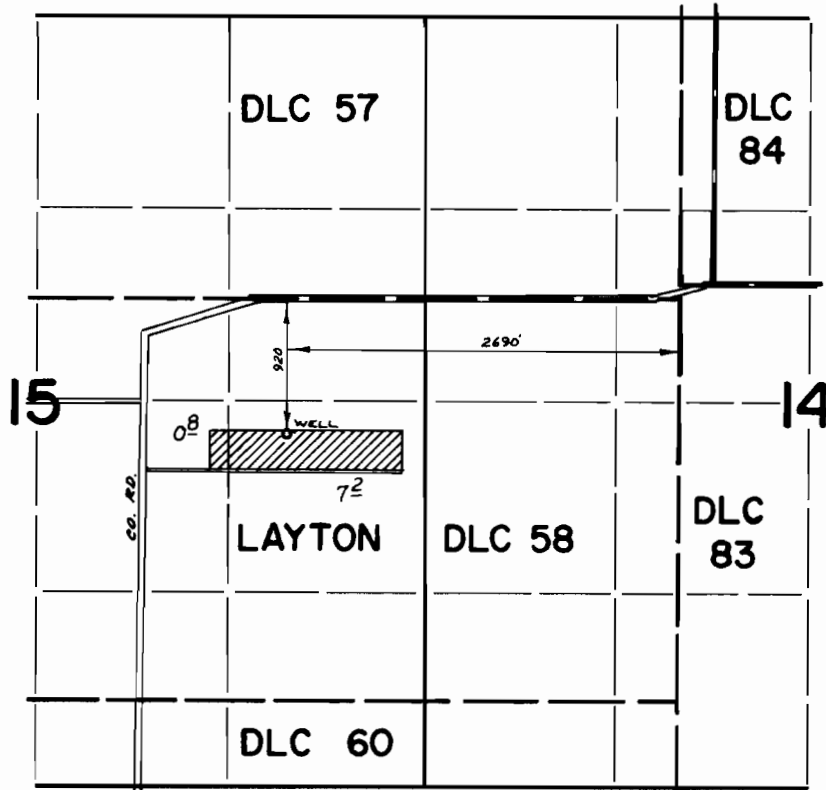

## FINAL PROOF SURVEY UNDER

Application No. G-3744 Permit No. G-3536  
IN NAME OF

JAMES F. AND VICTORIA E. CROCKETT

Surveyed April 5 1974, by S.P. Applegate