


T.10S.,R.3W.,W.M.

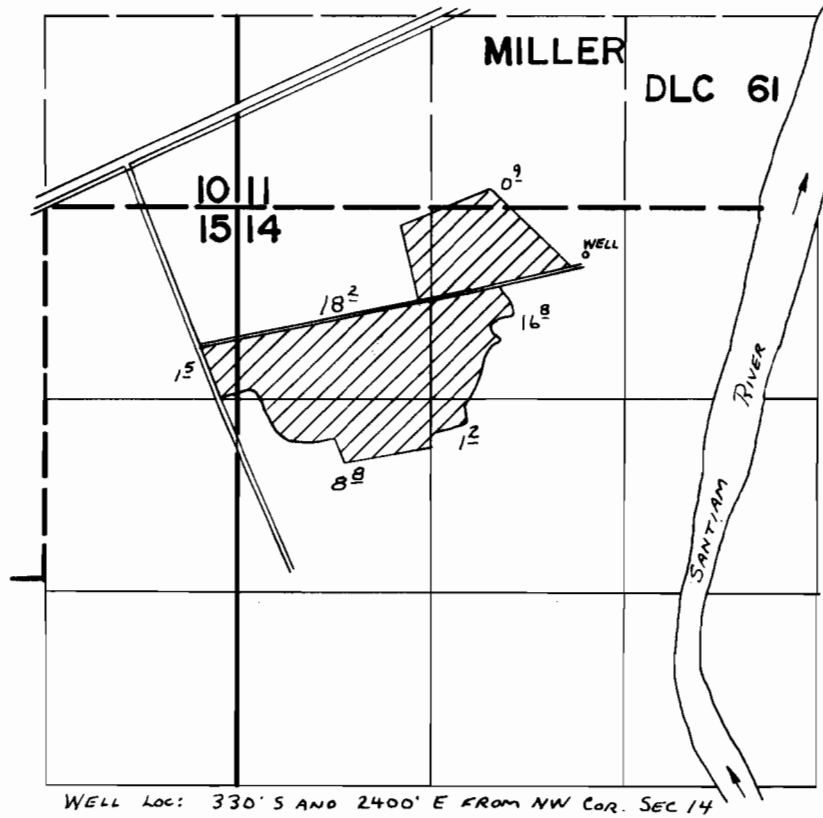

**FINAL PROOF SURVEY**  
UNDER

Application No. G-4206 Permit No. G-3970  
IN NAME OF

GEORGE V. & E. IRENE GRENZ

Surveyed JUNE 22 1973, by D. Norby