
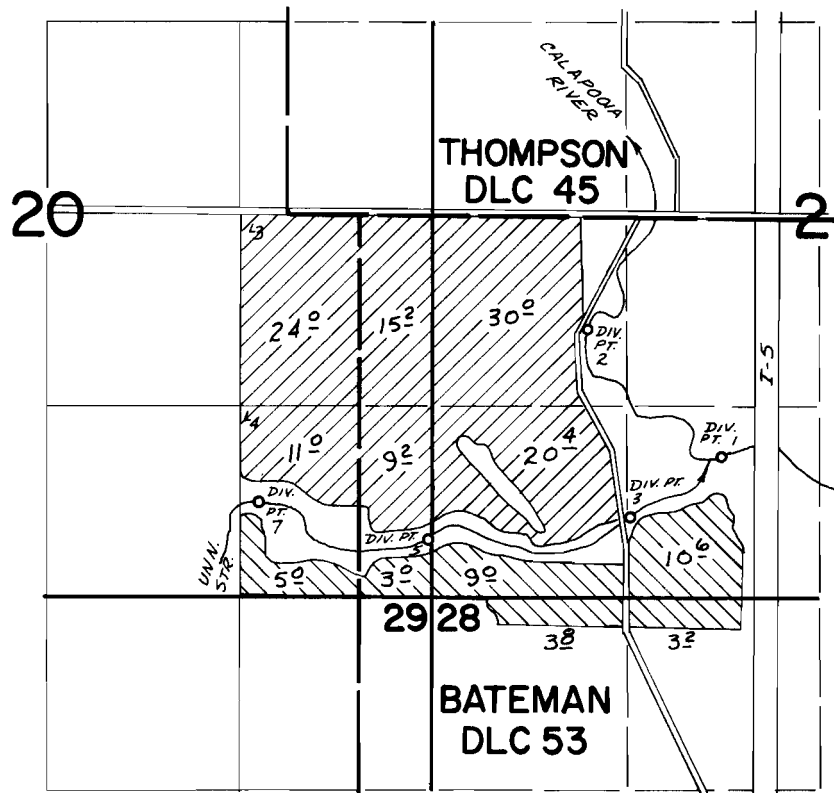
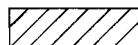


T.13S., R.3W., W.M.

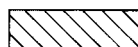

DIV. PTS. LOCATED: 1-1660'S & 2960'E; 2-790'S & 2050'E;
3-2080'S & 2340'E; 5-2230'S & 960'E; 7-1980'S & 200'W; ALL
FROM SW COR. THOMPSON DLC 45.

 Calapooia River

 Unnamed Stream and Calapooia River

FINAL PROOF SURVEY
UNDER

Application No. **42982** Permit No. **32113**
IN NAME OF

LEVERN AND LORA ELDER

Surveyed **Aug. 8** 19**74**, by **D.M. Norby**