


# T.13S., R.3W., W.M.

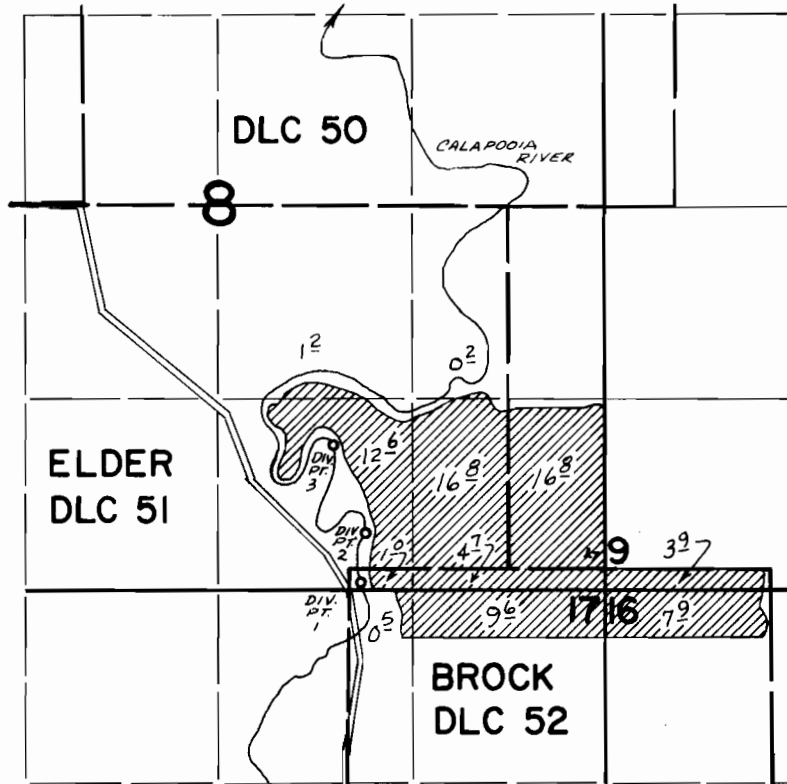

#1- 90°S. & 1670' W. #2- 240°N. & 1630' W. #3- 850°N. & 1850' W.  
 ALL FROM SE. CORNER LOT 7 (SE 1/4 SE 1/4) SEC. 8

## FINAL PROOF SURVEY UNDER

Application No. 42983 Permit No. 32114  
 IN NAME OF

LEVERN AND LORA ELDER

Surveyed Aug. 8 1974, by D.M. Norby