


T.12&13S., R.3W., W.M.

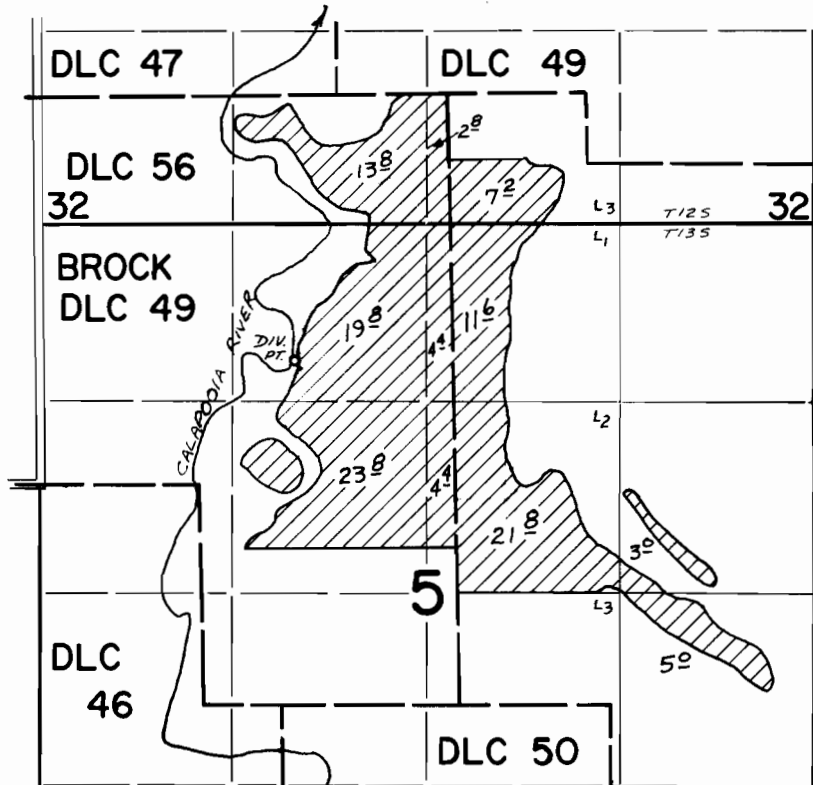

DIV. PT. LOCATED: 1840' S & 1030' W FROM NE COR BROCK DLC 56.

FINAL PROOF SURVEY UNDER

Application No. 42984 Permit No. 32115
IN NAME OF

LEVERN AND LORA ELDER

Surveyed Aug. 8 1974, by D.M. Norby