


T.9S., R.1&2E., W.M.

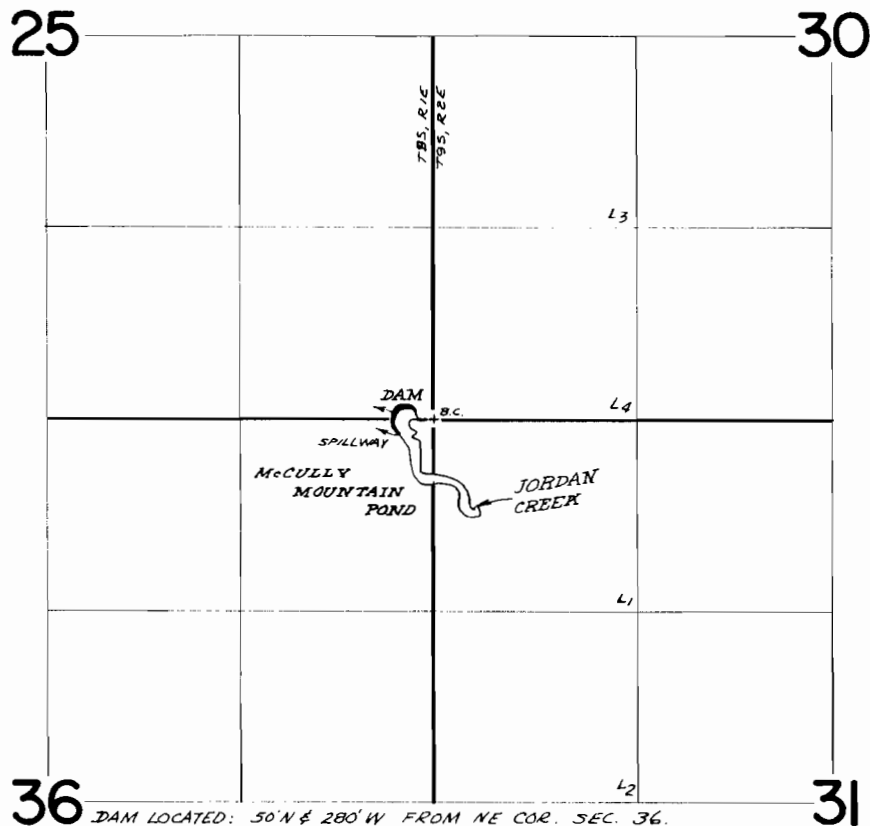

FINAL PROOF SURVEY
UNDER

R-46402 R-5528
Application No. 46600 Permit No. 34720
IN NAME OF

DANA, RUSSELL N. AND RUSSELL F. WILSON

Surveyed April 30 1974, by D. Norby