


T.9S., R.18&2E., W.M.

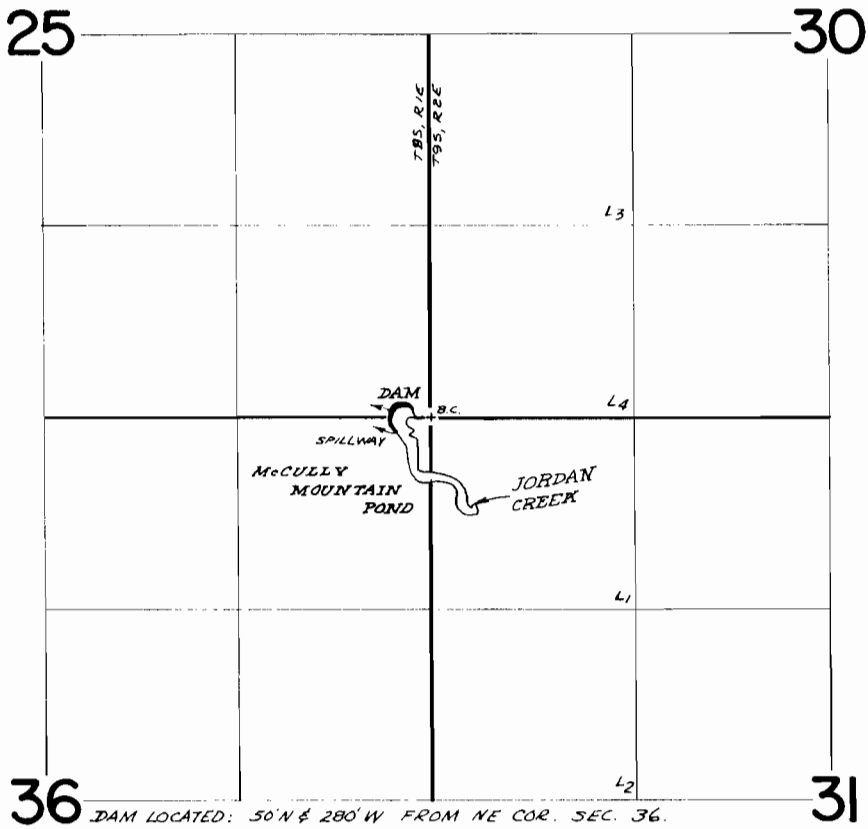

FINAL PROOF SURVEY
UNDER

Application No. **R-46402** Permit No. **R-5528**
46600 **34720**
 IN NAME OF

DANA, RUSSELL N. AND RUSSELL F. WILSON

Surveyed April 30, 1974, by D. Norby