


T.5S. R.3W. W.M.

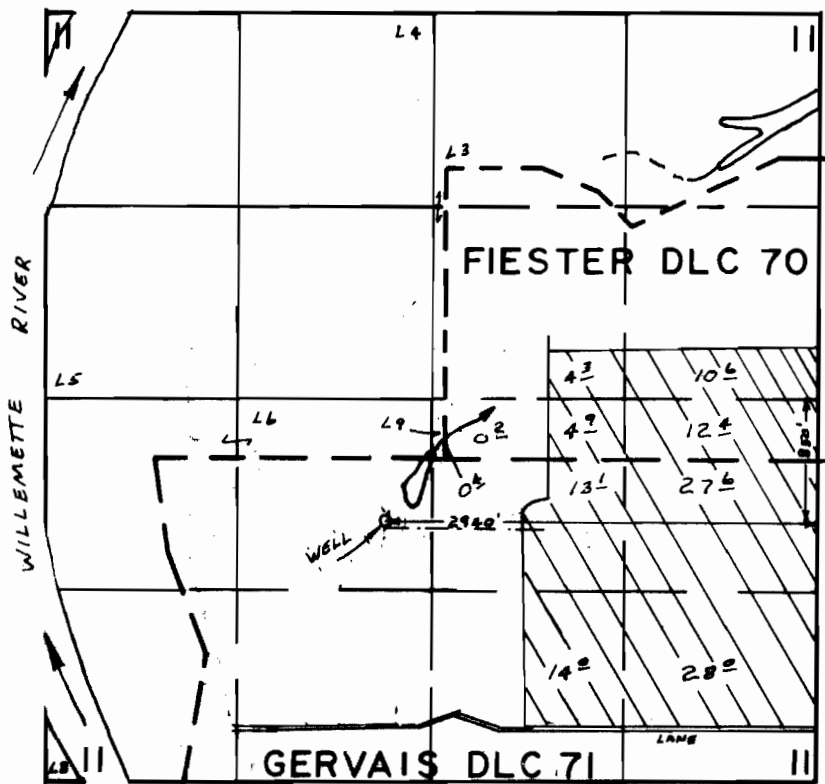

FINAL PROOF SURVEY UNDER

Application No. G-4371 Permit No. G-4123
IN NAME OF

OPAL M. MAHONY

Surveyed SEP 4 1974, by LH NUNN