


# T.5S R.1W. & E. W.M.

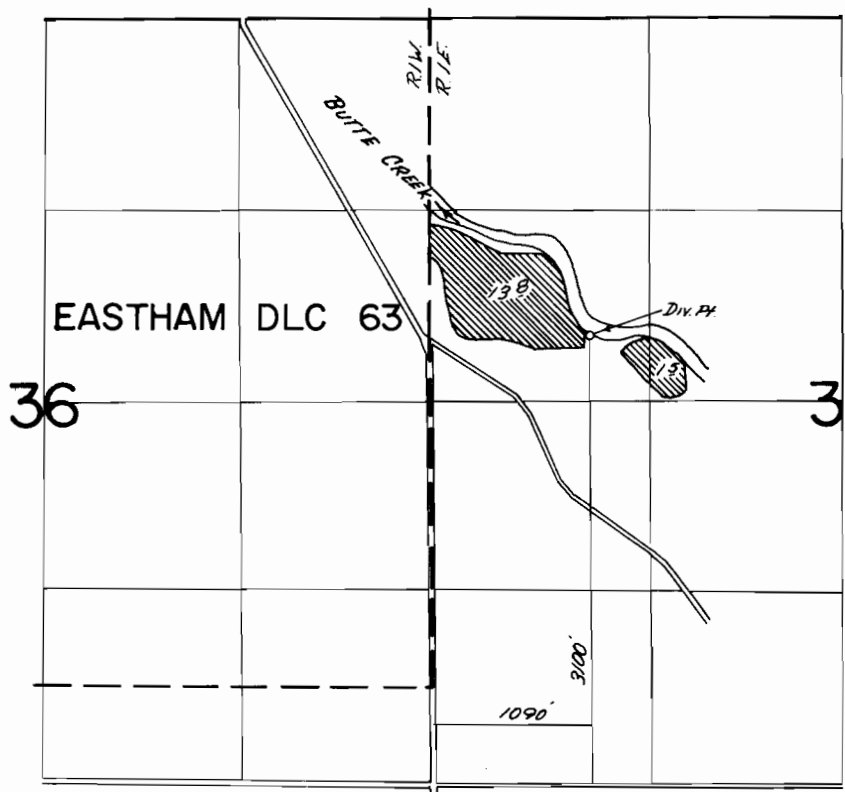

## FINAL PROOF SURVEY UNDER

Application No. 43154... Permit No. 32236...  
IN NAME OF

.....ALMA & CLARENCE L. MEDACK

Surveyed April 10, 1974, by T. J. PAUL.....