


T.68&7S. RIE. W.M.

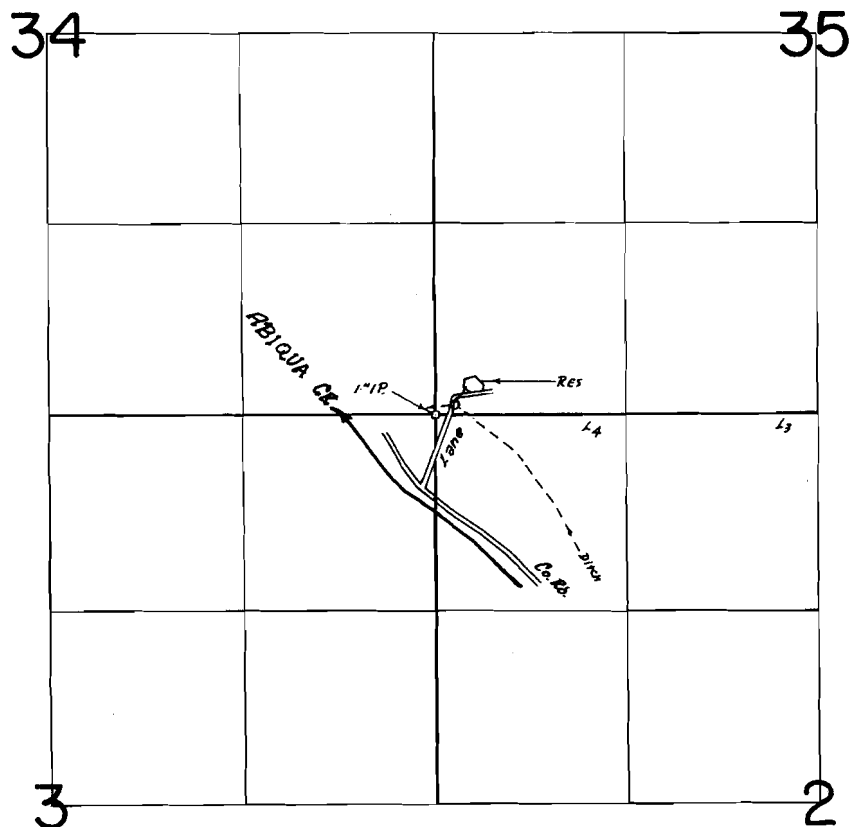

RES. LOC. 180' N & 200' E ; DIV. LOC. 60' N & 130' E BOTH FROM SW COR SEC 35

# FINAL PROOF SURVEY

## UNDER

Application No. R-48410 Permit No. R-5691  
48411 35419  
 IN NAME OF

LESTER ROBERTS

Surveyed Oct. 4, 1974, by T. J. PAUL