


T.6&7S. R1E. W.M.

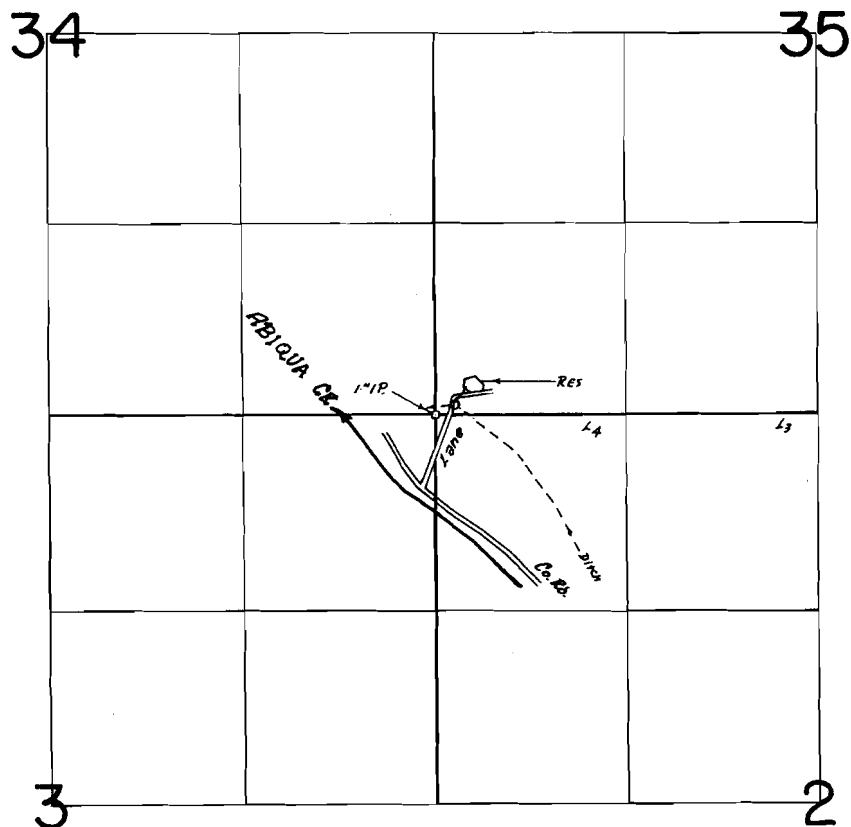

Res. Loc. 180' N & 200' E ; Div. Loc. 60' N & 130' E Both From SW Cor. Sec 35

FINAL PROOF SURVEY
UNDER

R-48410 R-5691
Application No. 48411 Permit No. 35419
IN NAME OF

LESTER ROBERTS

Surveyed Oct. 4, 1974, by T. J. PAUL