


T.8S., R.5W., W.M.

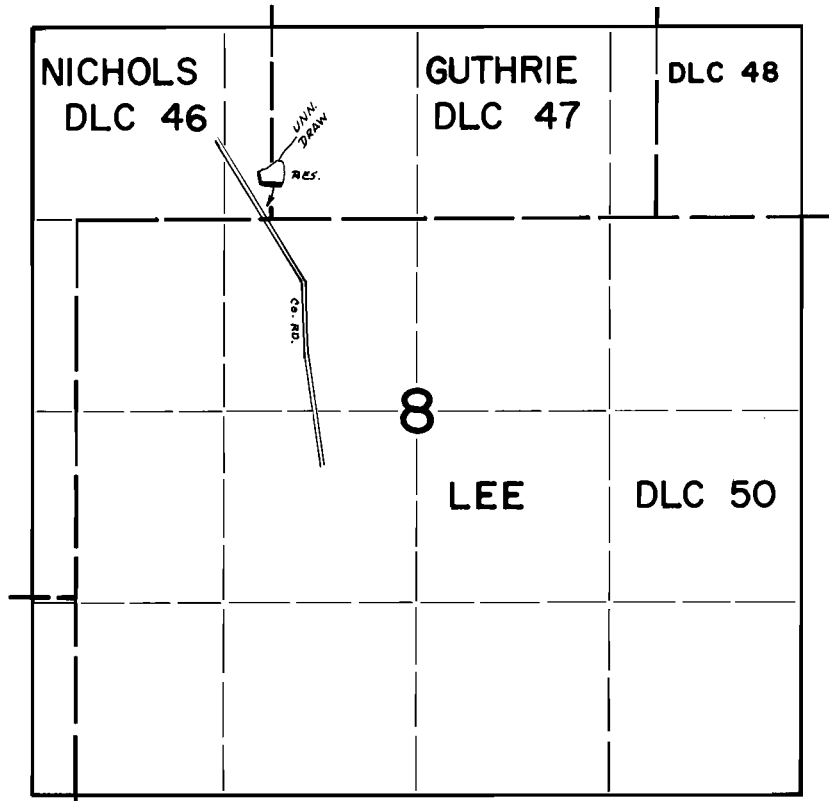

**FINAL PROOF SURVEY**  
UNDER

Application No. R-49388 Permit No. R-6009  
IN NAME OF

CARLYLE A. HAAS

Surveyed June 10 1975, by D. Norby