


T.9S., R.4W., W.M.

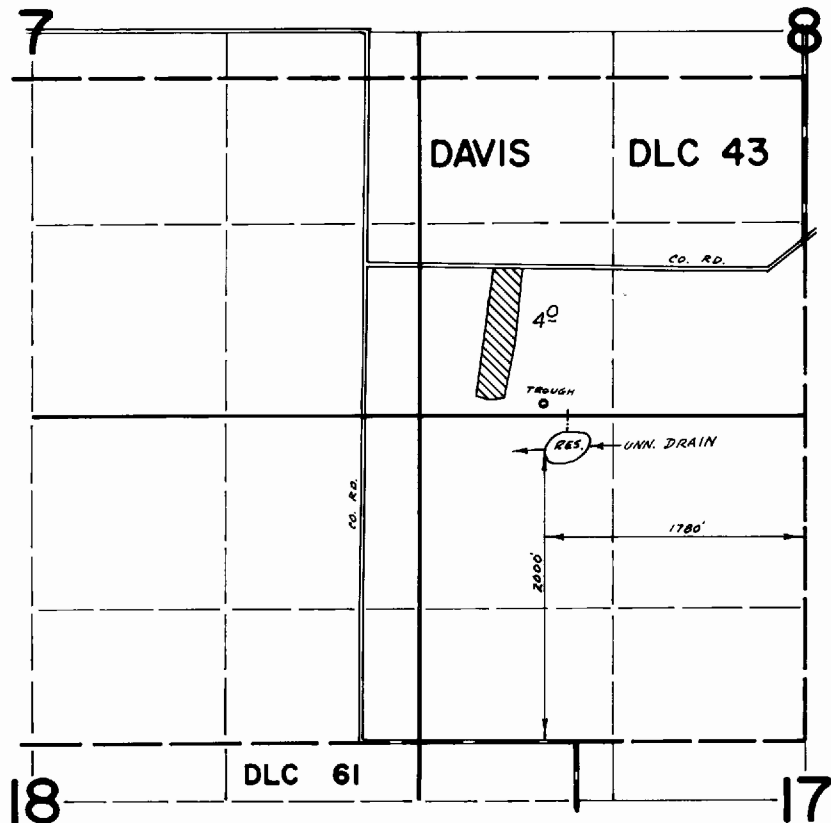

FINAL PROOF SURVEY
UNDER

Application No. R-46220 46221 Permit No. R-5498 34533
IN NAME OF

D.W. CHRISTIANSON

Surveyed June 30 1975, by D. Norby