


T.9S., R.6W., W.M.

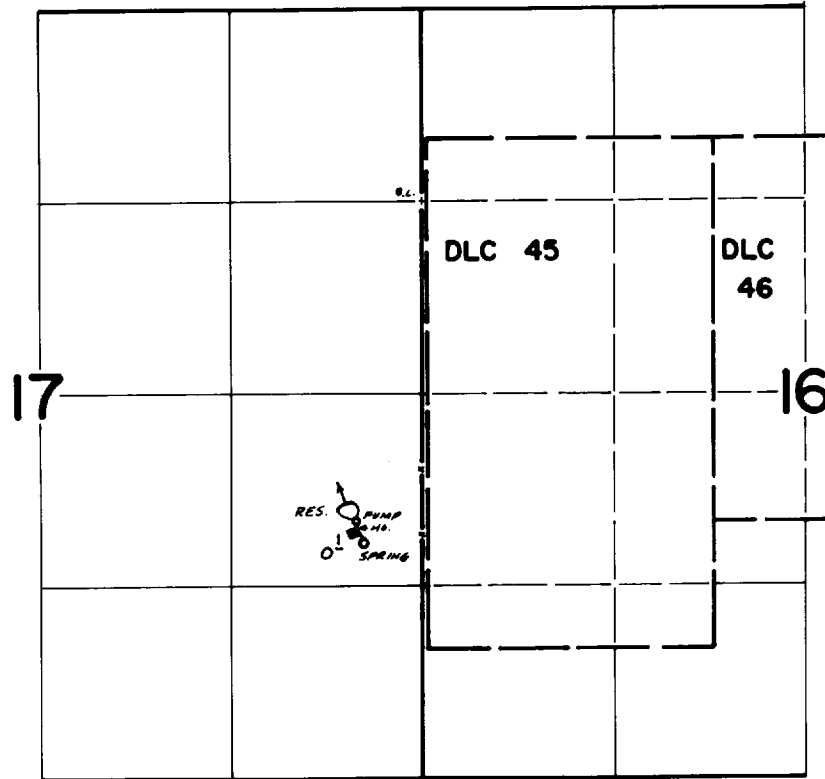

WELL PTS. LOC: SPR - 2340'S & 400'W; RES. - 2170'S & 530'W FROM NE COR. SE 1/4 NE 1/4 SEC 17.

FINAL PROOF SURVEY
UNDER

R-47507 R-5723
Application No. 47508 Permit No. 35582
IN NAME OF

ESTATE OF GERALD MORGAN

Surveyed June 13, 1975, by D. Norby