


T. 1 S. R. 2 W. W. M.

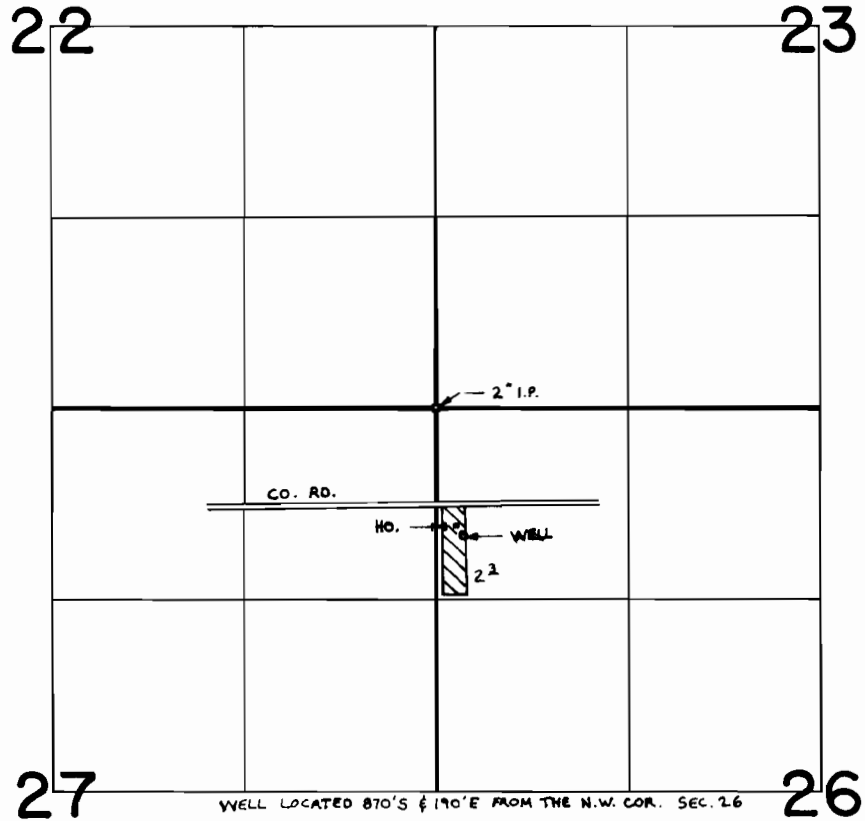

FINAL PROOF SURVEY
UNDER

Application No. G-3315 Permit No. G-3087
IN NAME OF

ROBERT JOHN ELSKAMP

Surveyed JULY 26 1974, by T. PAUL
MAY 16 1975 by R. MUCKEN