


T.1S. R.3W. W.M.

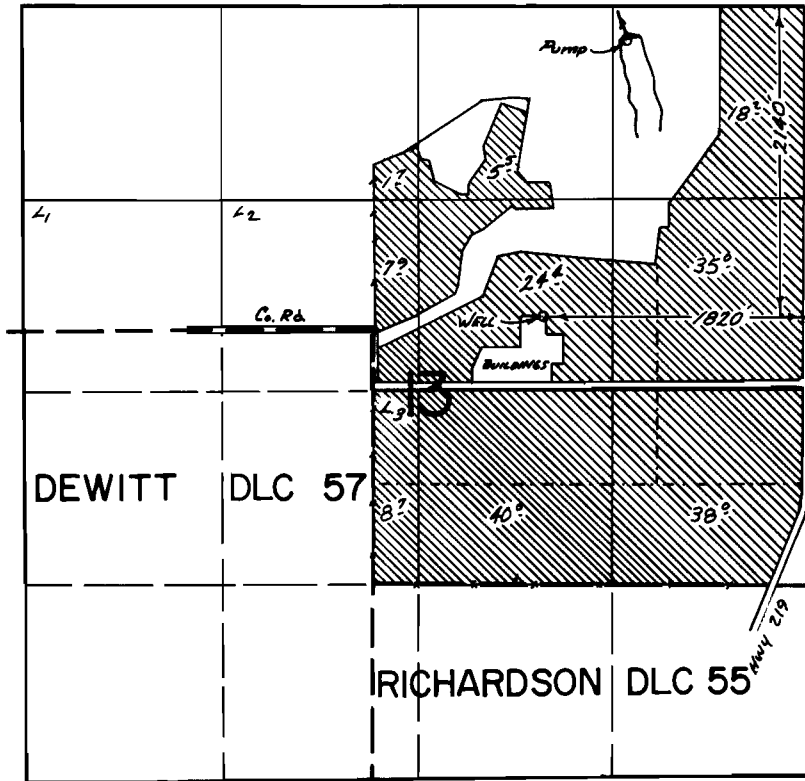

FINAL PROOF SURVEY
UNDER

Application No. G-5178.. Permit No. G-5052.
IN NAME OF

U. S. NATIONAL BANK AS TRUSTEE

Surveyed Sep...4... 1974, by R...G...MUCKEN