


T.1S. R.2W. W.M.

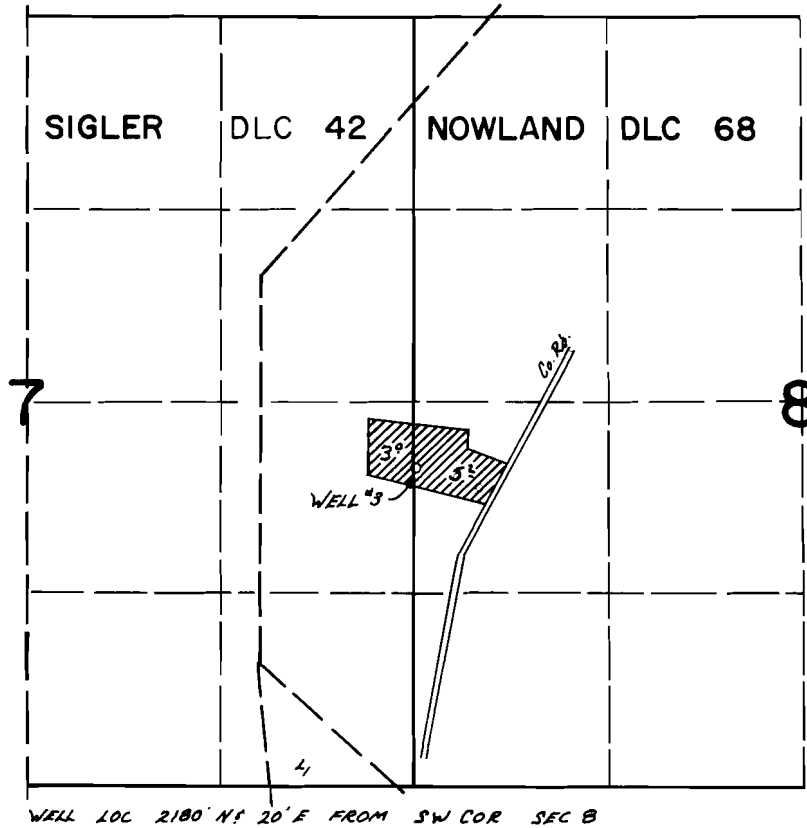

FINAL PROOF SURVEY
UNDER

Application No. G-5294 Permit No. G-5127
IN NAME OF

GLENN A. WALTERS

Surveyed July 23, 1974, by R. G. MUCKEN