


T.2S. R.2W. W.M.

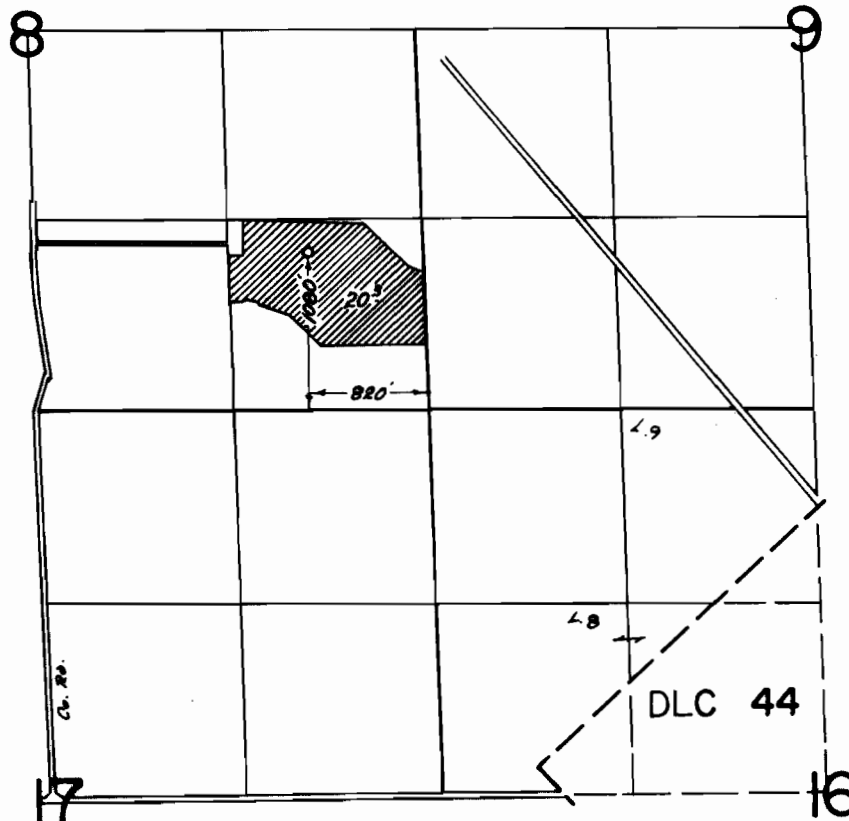

FINAL PROOF SURVEY
UNDER

Application No. G-6123... Permit No. G-5185...
IN NAME OF

GREEN FIELD PLANTATION, INC.

Surveyed June 20 1974, by R. G. MUCKEN.