


# T.1S. R.4W. W.M

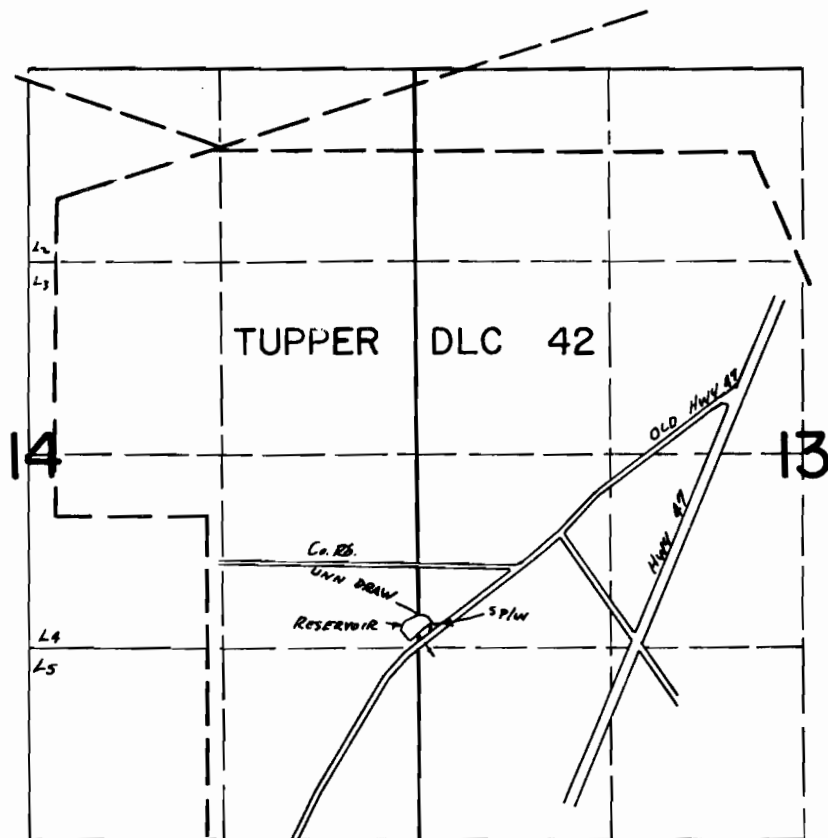

RES. LOC. 1420' N & 10' E FROM SW COR SEC 13.

## FINAL PROOF SURVEY UNDER

Application No. R-47369 Permit No. R-5701...  
IN NAME OF

..... GREGORY HAVENS .....

Surveyed Sep. 4, 1974, by R. G. MUCKEN