


T.1S. R.28&3W. W.M.

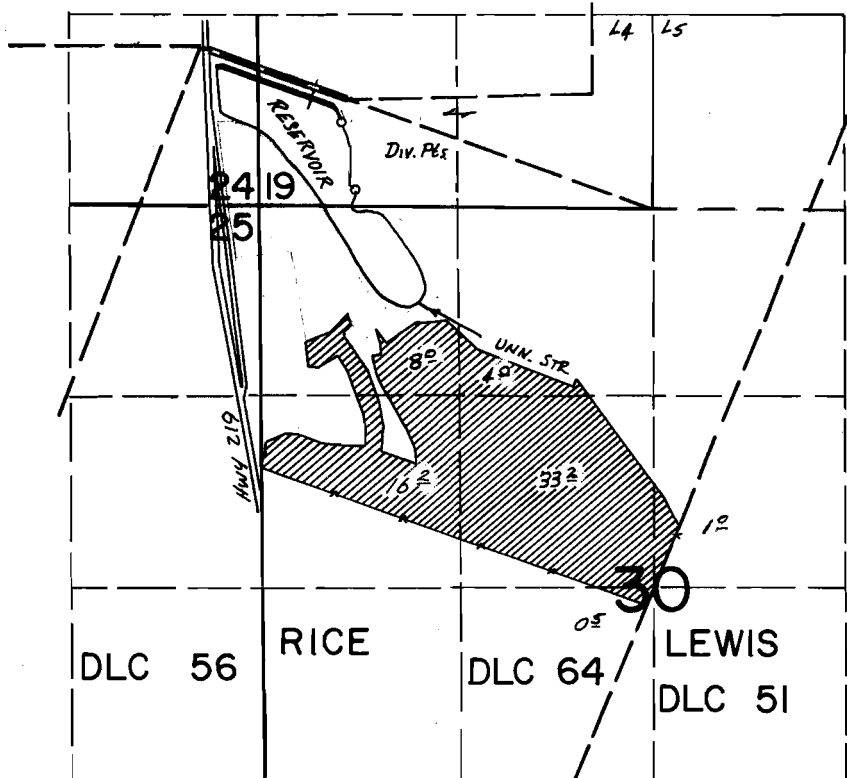

Div. Pts. Loc. 520' S & 960' E ; 1000' S & 1050' E BOTH FROM NW COR.
RICE DLC. 56

FINAL PROOF SURVEY
UNDER

Application No. 40937.. Permit No. 30505..
IN NAME OF

FRANK H. & IRIS G. TANKERSLEY

Surveyed July 2... 1974, by R...G...MUCKEN