


T.2S. R.2W. W.M.

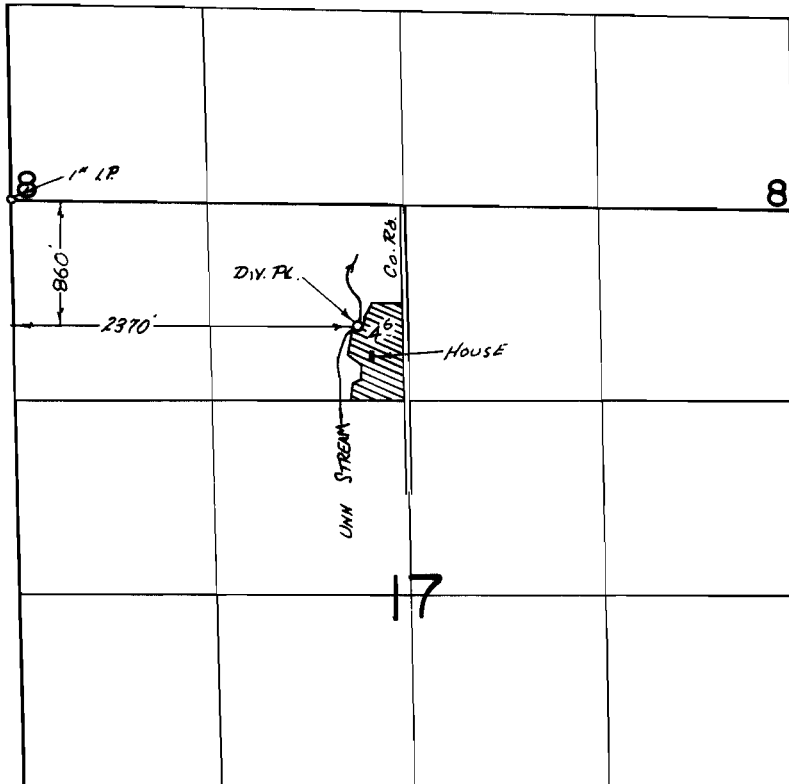

**FINAL PROOF SURVEY**  
UNDER

Application No. 42037... Permit No. 31119.....  
IN NAME OF

.....HENRY F. RUHLIN.....

Surveyed June 18, 1974, by R. G. MUCKEN