


T.2S. R.2W. W.M.

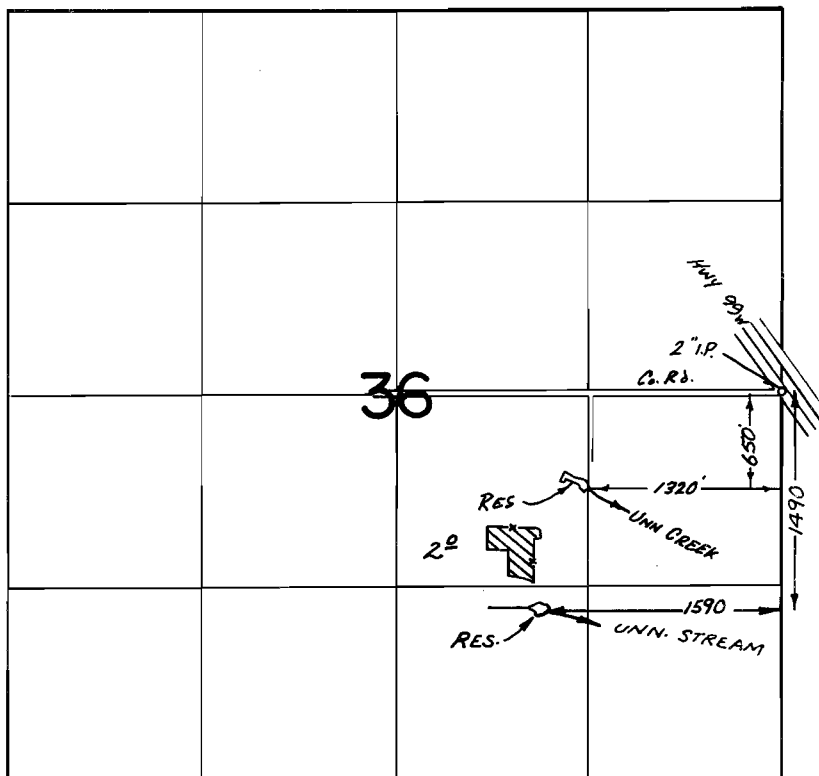

FINAL PROOF SURVEY

UNDER

R-49713

R-6042

49714

37236

R-41775

R-4710


Application No. 41719 Permit No. 31147

IN NAME OF

ROBERT A. FREITAG

Surveyed May 15, 1974, by R. G. MUCKEN
SEPT. 8 1976

T.2S. R.2W. W.M.

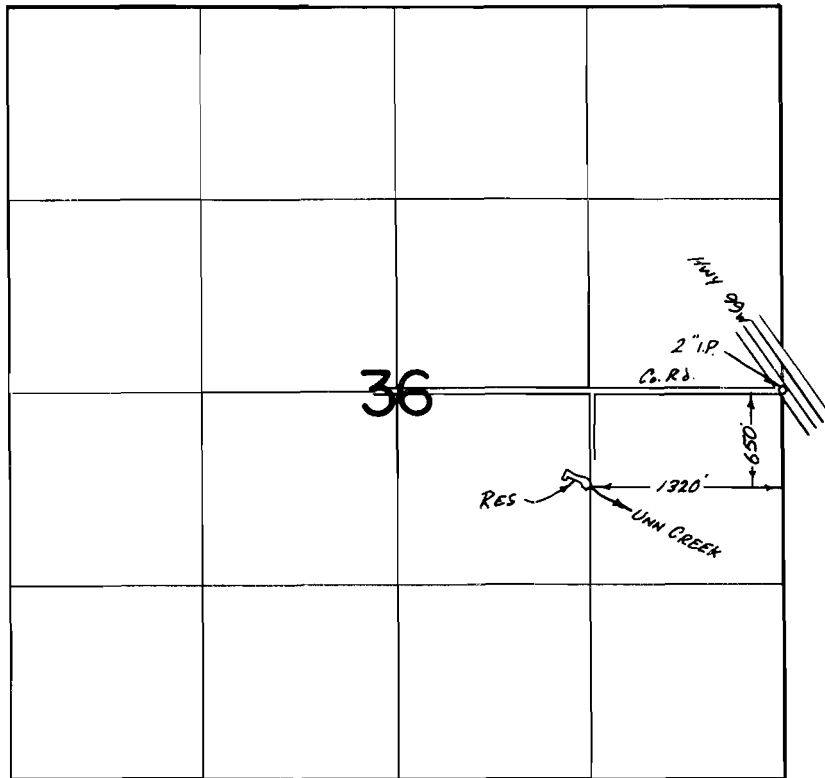

FINAL PROOF SURVEY
UNDER

R-41775 R-4710
Application No. 41719 Permit No. 31147
IN NAME OF

ROBERT A. FREITAG

Surveyed May 15, 1974, by R. G. MUCKEN