


T.2S. R.1W. W.M.

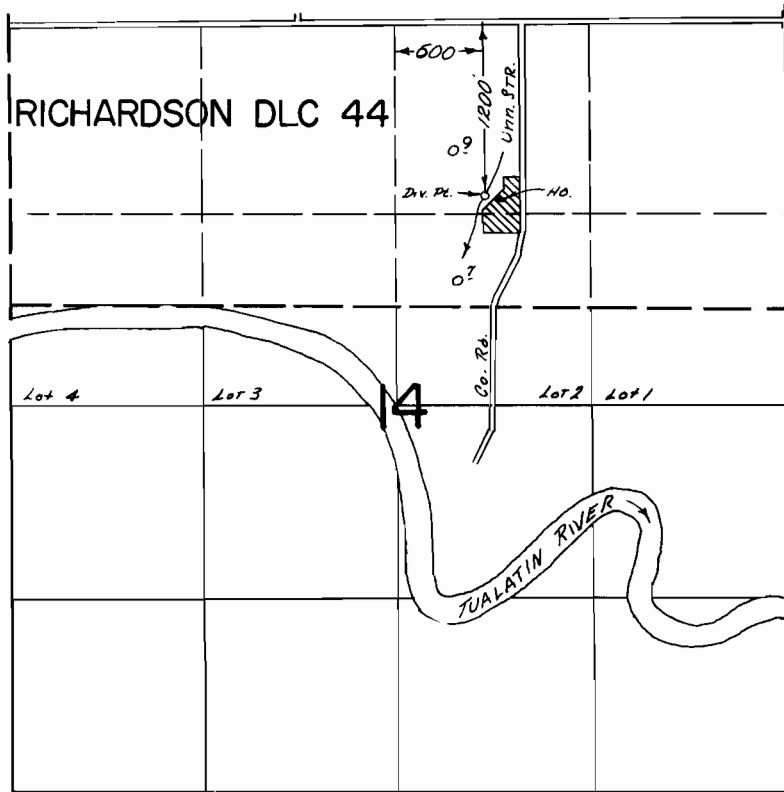

FINAL PROOF SURVEY
UNDER

Application No. 41915..... Permit No. 31259.....
IN NAME OF

ROBERT GORDON SCOTT

Surveyed May...17... 1974, by R...G...MUCKEN