


T.2N.R.2W.W.M.

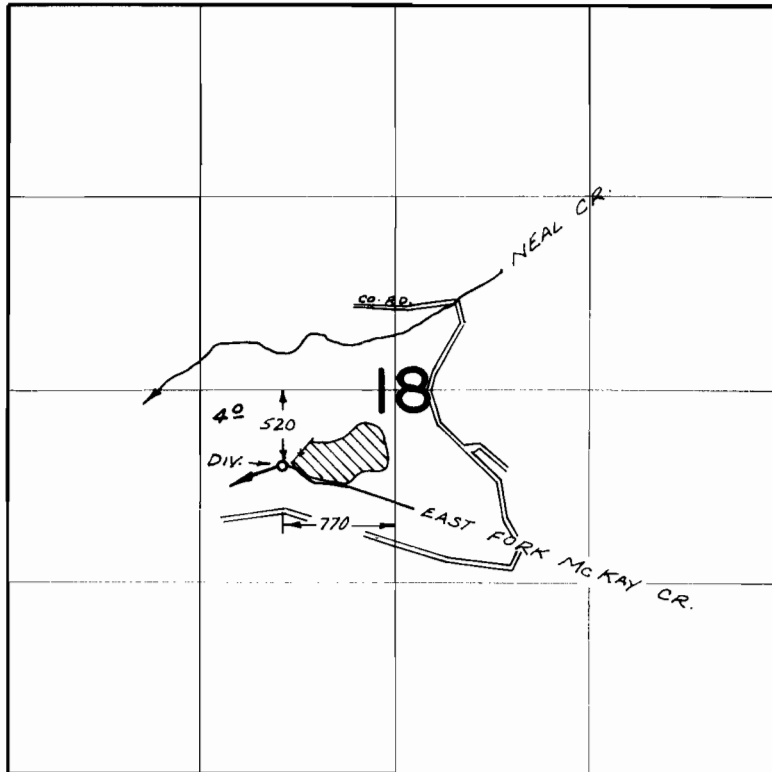

FINAL PROOF SURVEY
UNDER

Application No. 42605 Permit No. 31705
IN NAME OF

KENNETH LOGAN

Surveyed APR 2, 1974, by R. MUGKEN