


T.1S. R.3W. W.M.

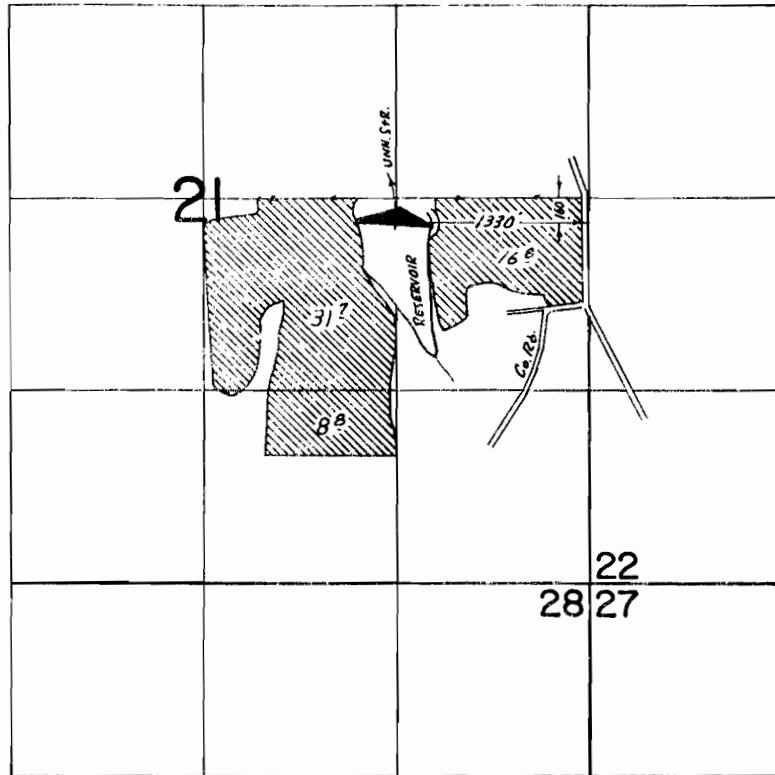

FINAL PROOF SURVEY
UNDER

R-44039 R-4962
Application No. 44040 Permit No. 32364
IN NAME OF

..... **WILLIAM F UNGER**

Surveyed July 24 1974, by R. G. MUCKEN