


T.2S. R.2W. W.M.

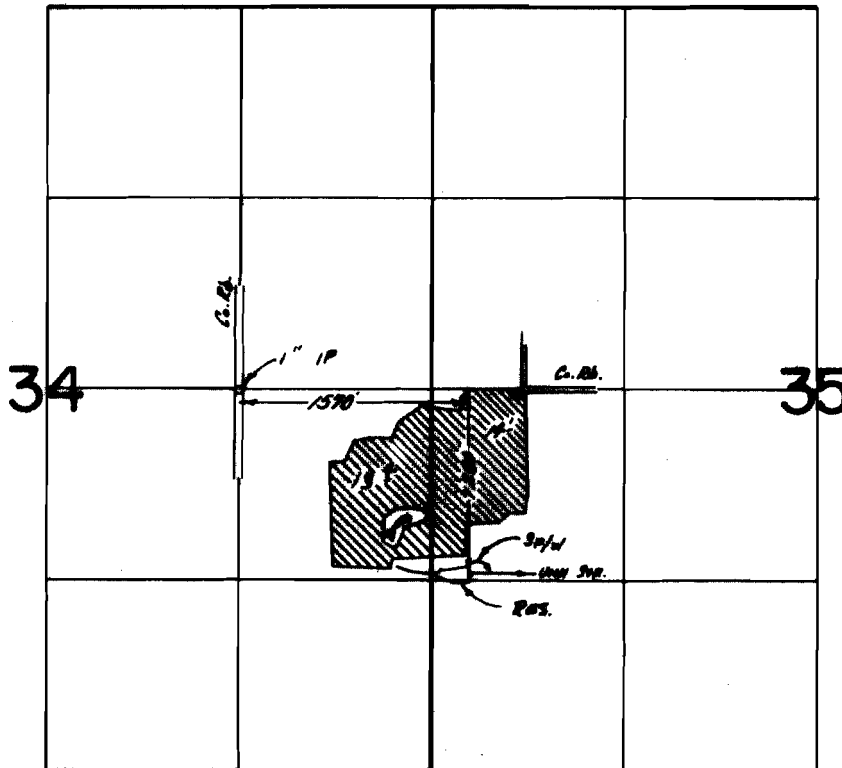

FINAL PROOF SURVEY
UNDER

R-43887 R-4973
Application No. 44079 Permit No. 32427
IN NAME OF

RICHARD B. JOYCE

Surveyed June 18 1974, by R. G. MUCKEN