


T.2S. R.2W. W.M.

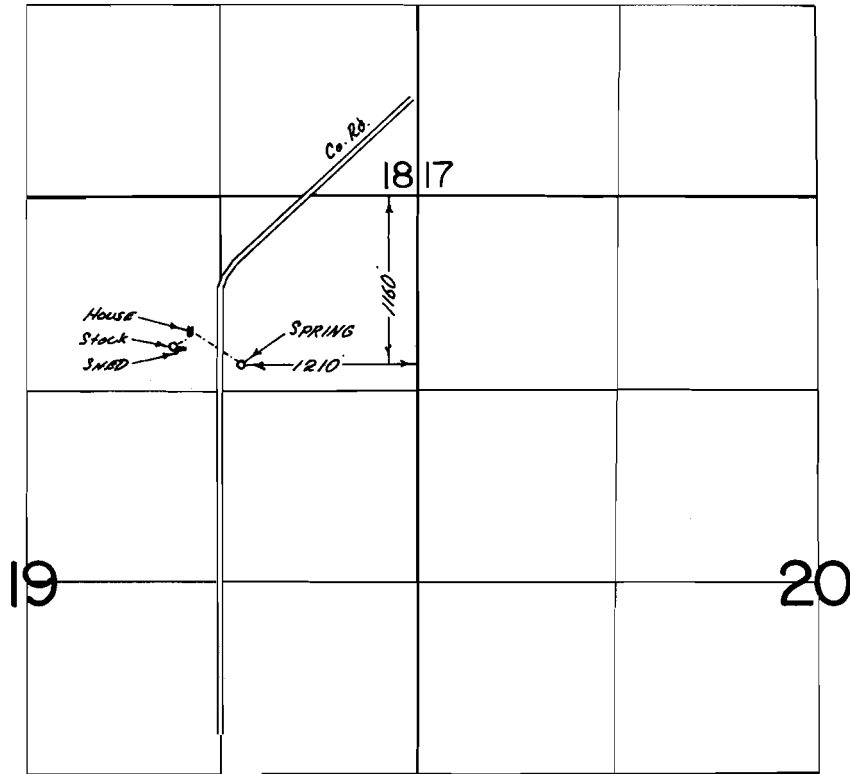

FINAL PROOF SURVEY
UNDER

Application No. 43411... Permit No. 32431...
IN NAME OF

HUBERT & JOYCE V. JANIKE

Surveyed June 20 1974, by R. G. MUCKEN