


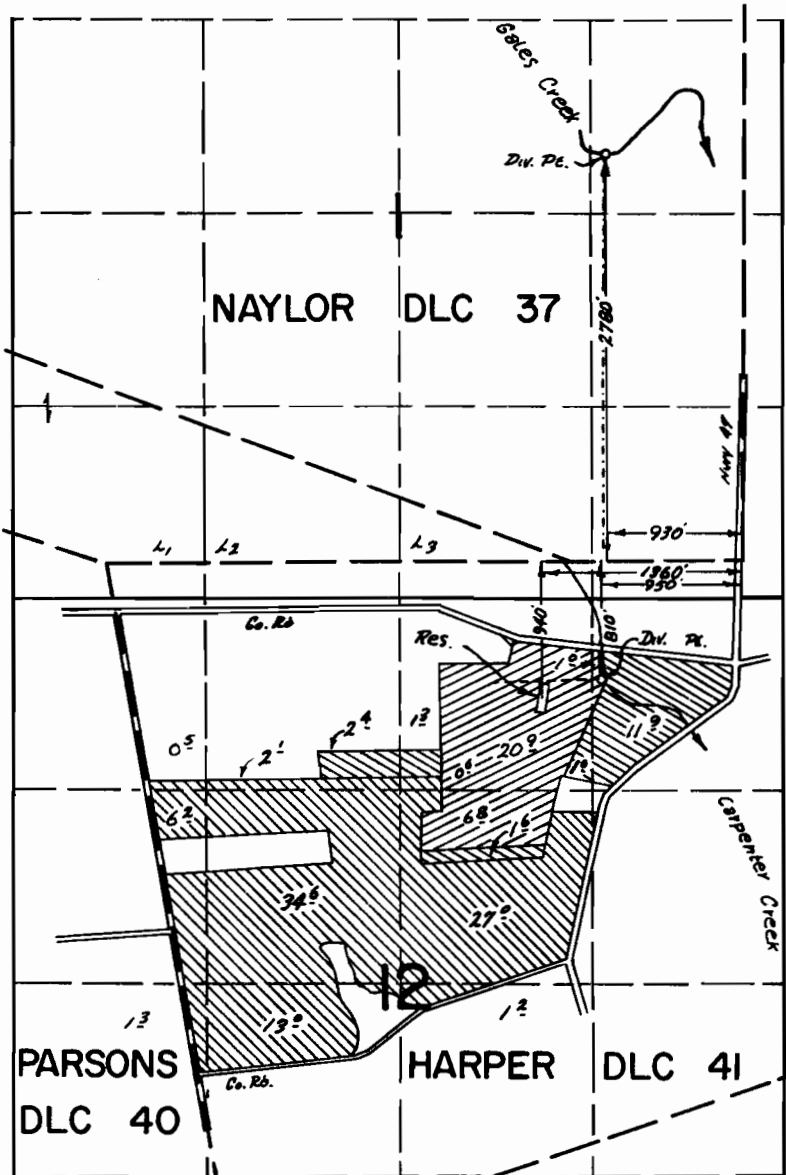


T.1S. R.4W. W.M



FINAL PROOF SURVEY UNDER

-  Primary A. # 43795
-  Supplemental A. # 43795
-  Primary A. # 45913

45913 34301
R-43794 R-5027
Application No. 43795 Permit No. 32722
IN NAME OF

ROBERT EPLER

Surveyed NOV. 8, 1974, by R. G. MUCKEN