


T.2S. R.2W. W.M.

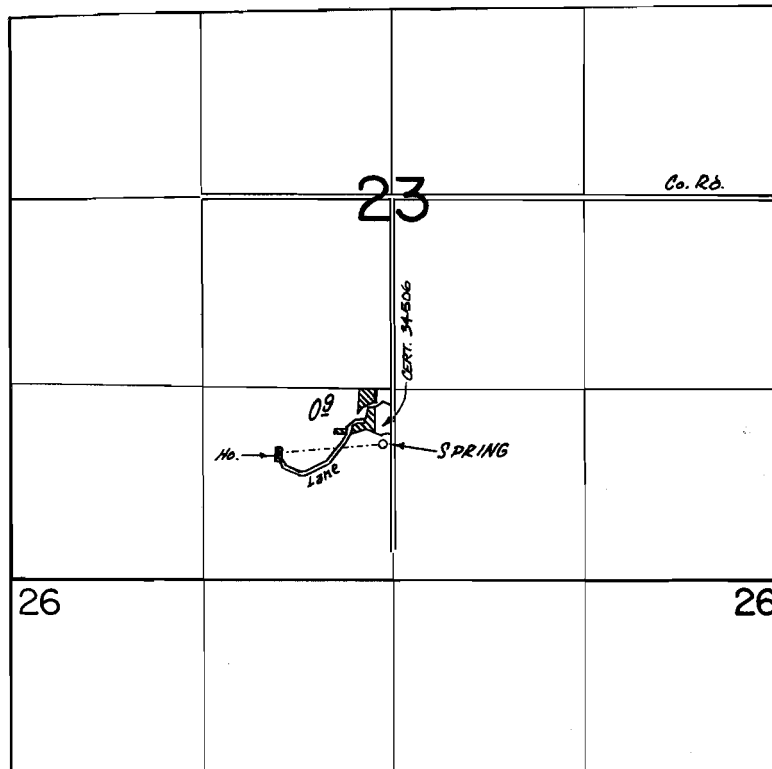

SPRING LOC. 1700 S + 60 W FROM CENTER SEC 23

FINAL PROOF SURVEY
UNDER

Application No. 44066 Permit No. 32928
IN NAME OF

NORMAN REE BRUSH

Surveyed May 16 1974, by R. G. MUCKEN