


land to west
30 feet
dep

T.1N.&1S. R.2W. W.M.

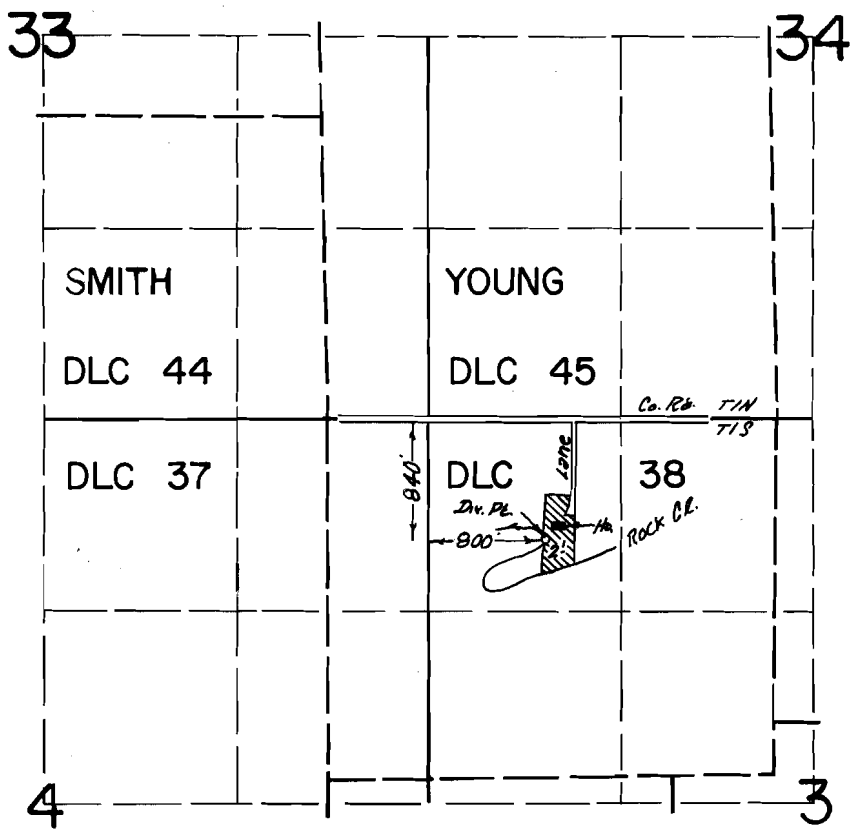

FINAL PROOF SURVEY
UNDER

Application No. 44307. Permit No. 33087.
IN NAME OF

VERNON DEE MOCK

Surveyed July 22 1974, by R. G. MUCKEN