
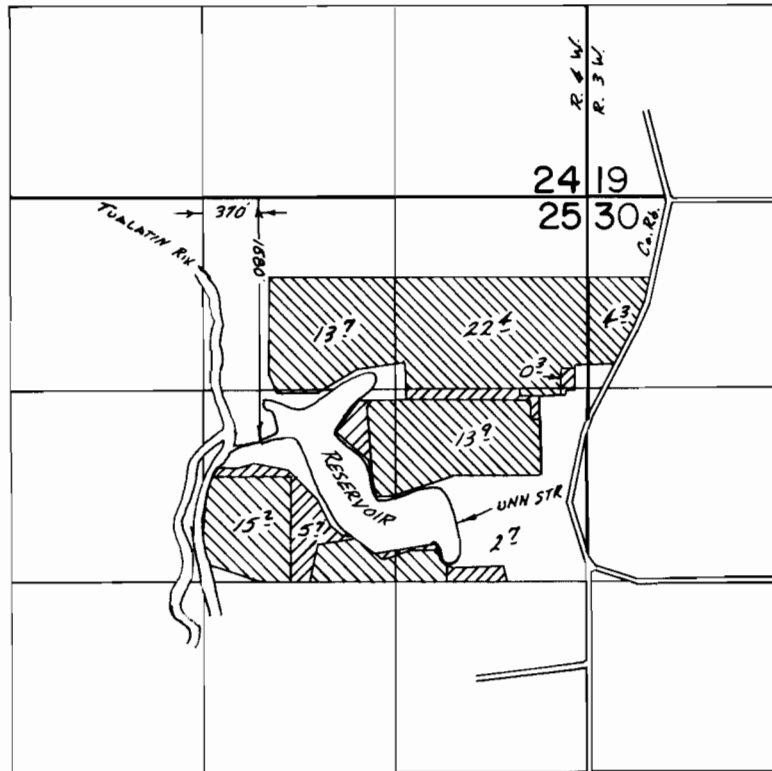
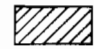


T. 1S. R. 38&4W. W.M.

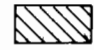

 Primary
 Supplemental

FINAL PROOF SURVEY
UNDER

R-43800 R-5267
Application No. ...43801. Permit No. ...33290.
IN NAME OF

..... VERNON H. VANDYKE

Surveyed Sep...6... 1974, by R.G. MUCKEN.