


T.2S. R.2W. WM

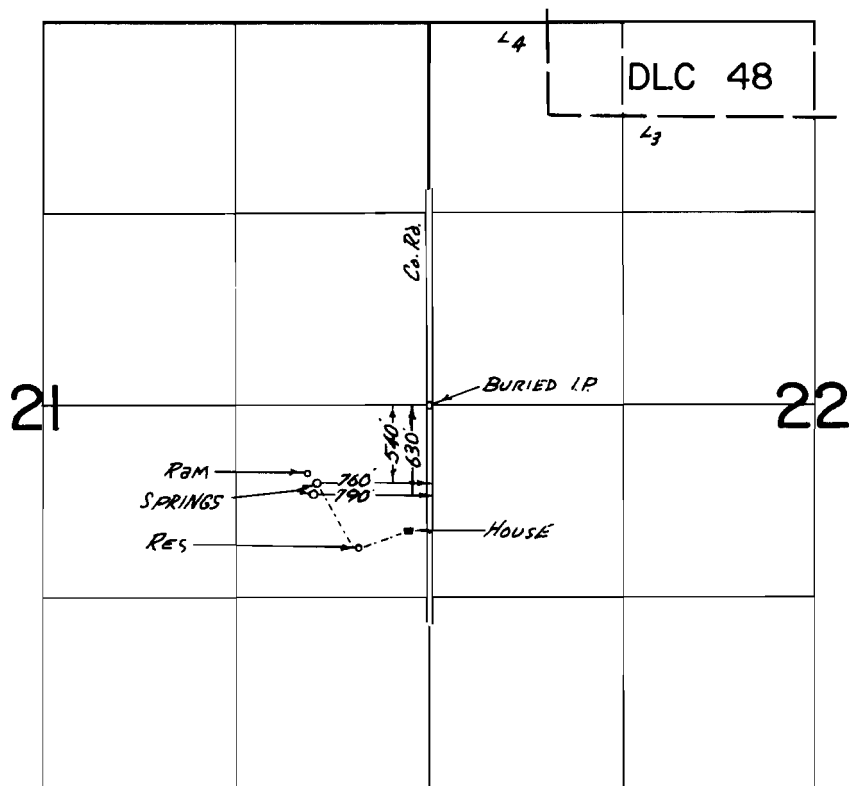

FINAL PROOF SURVEY UNDER

Application No. 45296.. Permit No. 33820...
IN NAME OF

FRANK J. FISCHER

Surveyed June 17, 1974, by R. G. MUCKEN