


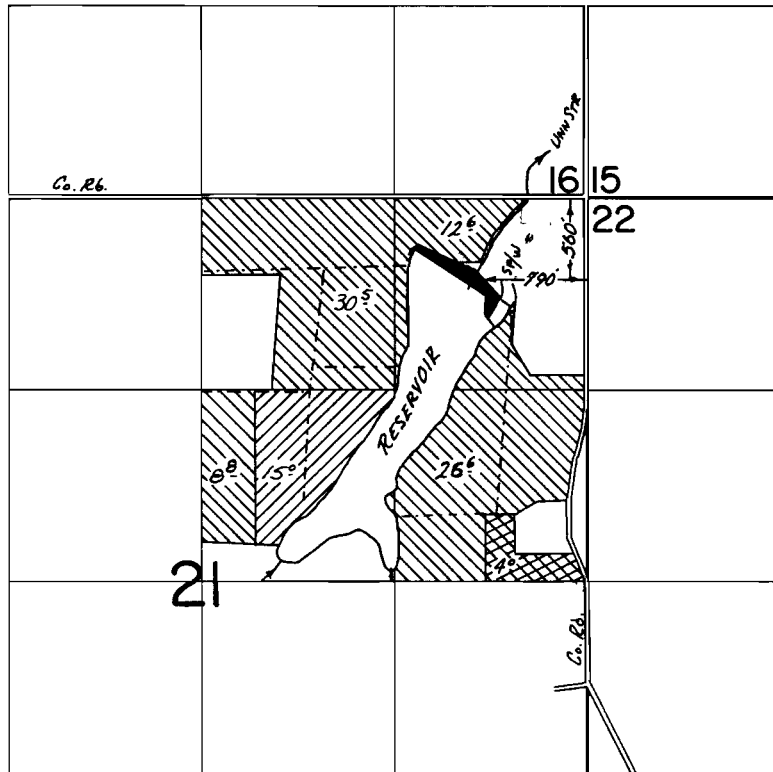


T.1S. R.3W. W.M.



-  Primary
  -  Supplemental
  -  Primary W-150 Supplemental
- A. # 46217

**FINAL PROOF SURVEY**  
UNDER

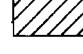Transfer No. W-150  
R-46216 R-5416  
Application No. 46217 Permit No. 34110  
IN NAME OF

GLENN WALTERS

Surveyed July...24 1974, by R...G...MUCKEN