


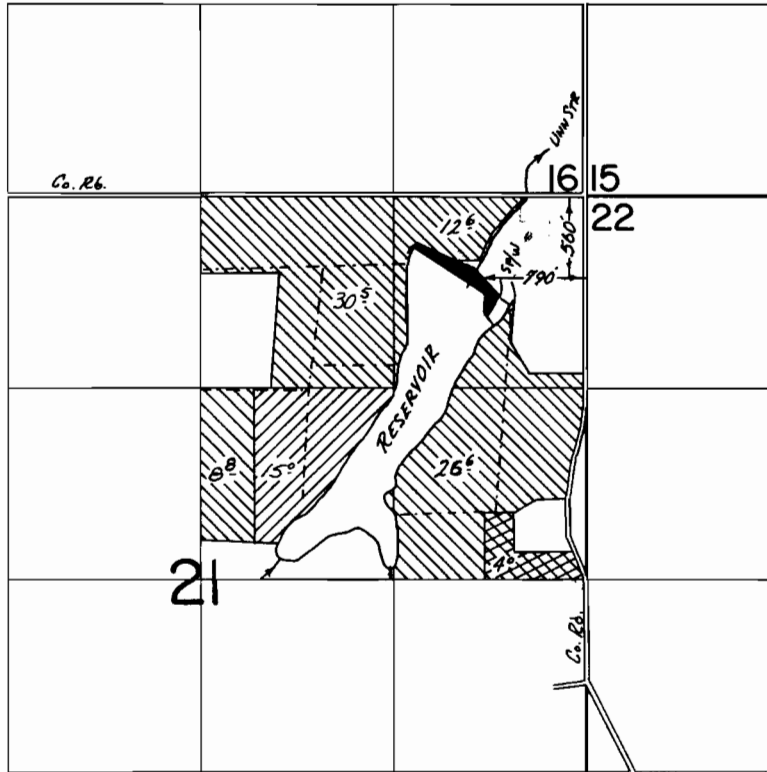


T.1S. R.3W. W.M.



-  Primary
-  Supplemental
-  Primary W-150  
Supplemental  
A. # 46217

**FINAL PROOF SURVEY**  
UNDER

Transfer No. W-150  
R-46216 R-5416  
Application No. 46217 Permit No. 34110.  
IN NAME OF

.....  
**GLENN WALTERS**  
.....

Surveyed July...24 1974, by R.G. MUCKEN