T.1S. R.4W. W.M

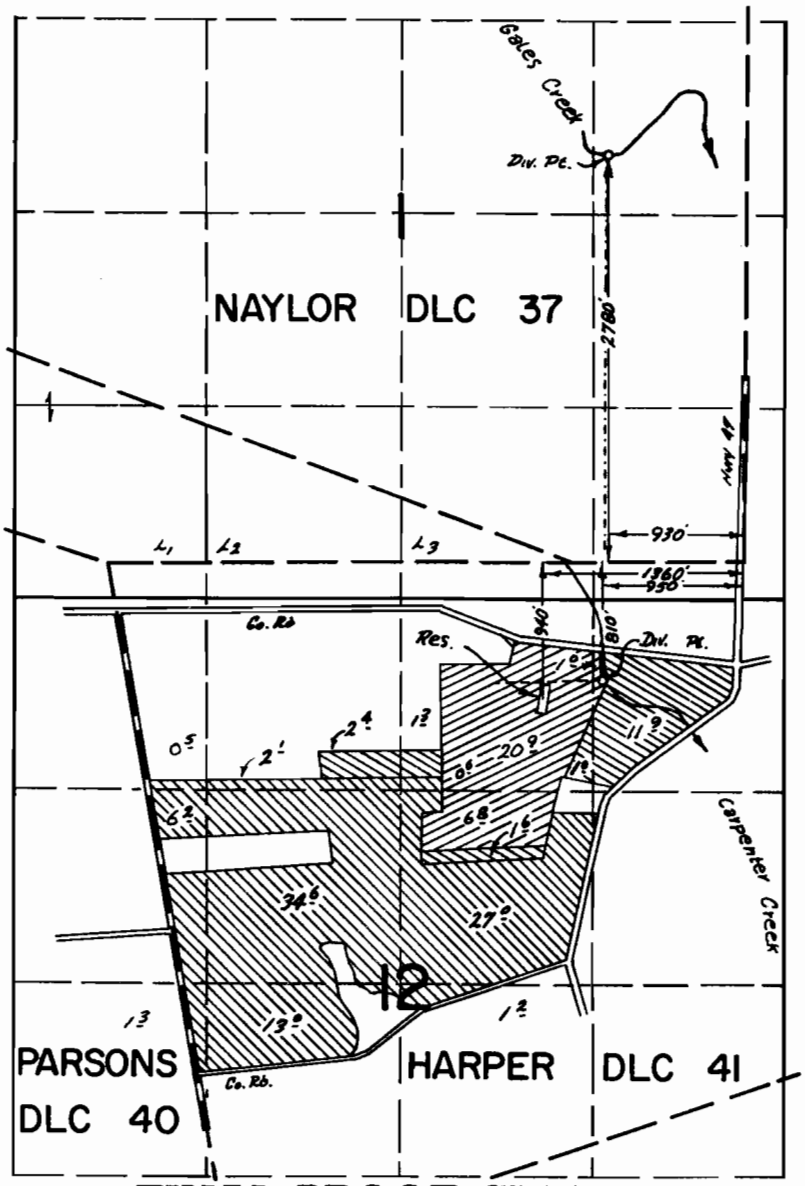

FINAL PROOF SURVEY

UNDER

Primary A.# 43795

Supplemental A.# 43795

Primary A.# 45913

45913 34301
R-43794 R-5027
Application No. 43795 Permit No. 32722
IN NAME OF

ROBERT EPLER

Surveyed NOV. 8 1974, by R. G. MUCKEN

DBS-2CL-32 TP